

Lishonings
C 7
9-5-69

MISSISSIPPI
BOARD OF WATER COMMISSIONERS
416 North State Street
Jackson, Mississippi 39201

CODED

WATER WELL DRILLERS LOG

CODED

Sept 5 - 1969 Hughes well Drilling Lishon
date well completed firm name county well located

LANDOWNER: L J Davidson
1768 Georgian Dr
Memphis Tenn.
(mailing address)

description of formations encountered	from	to
Gravel	0	37
Grey Rock	37	75
and Deeper strata	at	75 ft

WELL LOCATION:
sec. 26 T. 2 N R. 11 E
at Eastport
miles (distance) (direction) (nearest town)

WELL PURPOSE: Cabin
(home, irrigation, municipal, industrial)


- WELL COMPLETION DATA:
- (1) diameter (inches) 6 5/8
 - (2) total depth (feet) 75
 - (3) static water level (feet) 20 below top of ground.
 - (4) casing Steel, 37 (material) (depth)
 - (size) If telescope see back.
 - (5) screen (length) (depth to top)
 - (size) (material)
 - (6) pump (HP) (yield gpm)
 - (type power)
 - (7) electric log (yes or no)
 - (organization running log)
 - (8) how well bottom plugged

DRILLERS REMARKS:
Owner furnishes pump

SEP - 9 1969
MISS. BD. OF WATER COMMISSIONERS

If well telescopes please sketch and show depths.

GROUND LEVEL

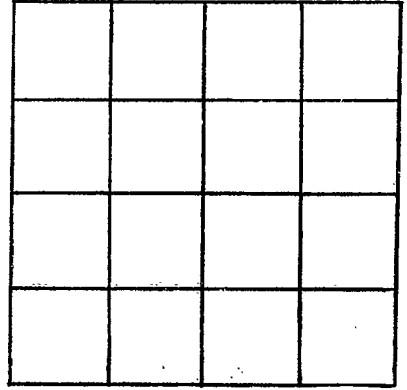

SECTION 26

Please indicate well location X.

ADDITIONAL INFORMATION

If more than one screen, show locations of each on sketch.