

MISSISSIPPI DEPARTMENT OF NATURAL RESOURCES

Bureau of Land and Water Resources

37 Arc
P.O. Box 10631
Jackson, Mississippi 39209
WATER WELL DRILLERS LOG

COUNTY WELL LOCATED	
<i>Washington</i>	
WELL NUMBER	CODED
<i>12</i>	<input checked="" type="checkbox"/>
DATE WELL COMPLETED	
<i>10-1-91</i>	

PERMIT NUMBER
NAME OF DRILLING FIRM
<i>Knapp Drilling Co.</i>

NAME & MAILING ADDRESS OF LANDOWNER			
<i>Johnny Burt</i>			
<i>Rt 5</i>			
<i>Juka, MS. 38852</i>			
WELL LOCATION: SEC TOWNSHIP RANGE			
<i>29</i>	<i>2</i>	<i>S</i>	<i>11</i>
DISTANCE DIRECTION NEAREST TOWN			
<i>6</i>	<i>NE</i>	<i>of Juka</i>	
OTHER LANDMARK			
WELL PURPOSE: Home, Irrigation, Municipal, Industrial, Fish Pond, etc.			
<i>Home</i>			


PUMP DATA			
PUMP TYPE (Circle One):			
<input checked="" type="checkbox"/> Submersible	<input type="checkbox"/> Turbine,	<input type="checkbox"/> Jet	<input type="checkbox"/> Flowing Well,
Other (Describe) _____			
POWER TYPE (Circle One):			
<input checked="" type="checkbox"/> Electric	<input type="checkbox"/> Tractor,	<input type="checkbox"/> Diesel,	<input type="checkbox"/> Gasoline, Butane,
Other (Describe) _____			
Pump Capacity (GPM)	No. of Stages	Setting Depth	
<i>10 gpm</i>	<i>9</i>	<i>140</i> FT.	
PUMP TEST			
Well yielded <i>15</i> GPM with			
a drawdown of _____ ft.			
after _____ hours of pumping			

WELL DATA		
Well Depth	Casing Diameter (In.)	Casing Length (Ft.)
<i>150 ft</i>	<i>6 in</i>	<i>30 ft</i>
Type of Casing	Hole Depth	Depth to Static Water Level
<i>PVC</i>	<i>150 ft</i>	
TYPE OF COMPLETION (Circle One or More):		
<input type="checkbox"/> Gravel Packed,	<input type="checkbox"/> Underreamed,	<input type="checkbox"/> Telescoped,
<input type="checkbox"/> Natural Development,	<input type="checkbox"/> Open Hole,	<input type="checkbox"/> Other
(Describe) _____		
Top of Lap Pipe or Reduction in Casing		
FEET	IF TELESCOPED OR MORE THAN ONE SCREEN: USE BACK PAGE	

LOG DATA	
TYPE OF LOG RUN (Circle One):	
<input type="checkbox"/> Electric,	<input checked="" type="checkbox"/> No Log Run,
<input type="checkbox"/> Gamma Ray, Density,	<input type="checkbox"/> Sonic, Neutron,
Other (Describe) _____	
Name of Organization Running Log	


SCREEN DATA		
Diameter - Inches	Length - Feet	Slot Size - Inches
Screen Type		Depth to Bottom - Feet

GEOLOGIC DATA (Office Use Only)			
Surface Elev.	Geologic Unit	Unit Thickness	Depth to Top
Subs. SWL	Date	Analysis	Aquifer Test
Driller's Remarks			

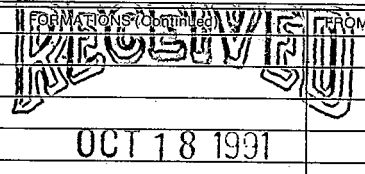DESCRIPTION OF FORMATIONS ENCOUNTERED	FROM	TO	FORMATION (Continued)	FROM	TO
					
Dept. of Environmental Quality Bureau of Land & Water Resources					
IF MORE SPACE IS NEEDED, USE BACK					

If well telescopes please sketch and show depths.

GROUND LEVEL

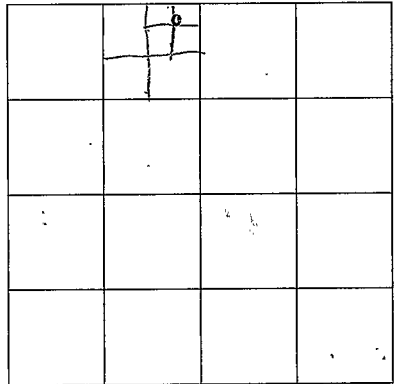

SECTION 29

Please indicate well location X.

ADDITIONAL INFORMATION

If more than one screen,
show location of each on sketch.