

ISHOMINGO  
 C 2000

MISSISSIPPI  
 BOARD OF WATER COMMISSIONERS  
 416 North State Street  
 Jackson, Mississippi 39201

WATER WELL DRILLERS LOG

Aug 28 1989 date well completed  
 Knox Drilling Co. firm name  
 Ishomingso county well located

LANDOWNER: Lester Depter  
 Route 2 Box 500  
 Iuka, MS.  
 (mailing address)

description of formations encountered	from	to
Clay & gravel	1	150

WELL LOCATION:  
 sec 29 T 2 S R 11 E  
 6 miles NE of Iuka  
 (distance) (direction) (nearest town)

WELL PURPOSE: Home  
 (home, irrigation, municipal, industrial)

- WELL COMPLETION DATA:
- (1) diameter (inches) 6 in
  - (2) total depth (feet) 150 ft.
  - (3) static water level (feet) \_\_\_\_\_ below top of ground.
  - (4) casing (material) 40 (depth) 40  
 6 in if telescope see back. (size)
  - (5) screen (length) \_\_\_\_\_ (depth to top) \_\_\_\_\_  
 (size) \_\_\_\_\_ (material) \_\_\_\_\_
  - (6) pump (HP) \_\_\_\_\_ (yield gpm) \_\_\_\_\_  
 (type power) \_\_\_\_\_
  - (7) electric log NO (yes or no)  
 (organization running log) \_\_\_\_\_
  - (8) how well bottom plugged gravel

RECEIVED


SEP 22 1989

Department of Natural Resources  
 Bureau of Land & Water Resources

DRILLERS REMARKS:

If well telescopes please sketch and show depths.

GROUND LEVEL

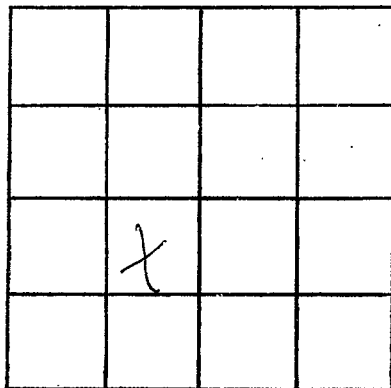

SECTION 29

Please indicate well location X.

ADDITIONAL INFORMATION

If more than one screen,  
show locations of each on sketch.