

TISHOMINGO

MISSISSIPPI BOARD OF WATER COMMISSIONERS

D 16

7-23-65

WATER WELL DRILLERS LOG

Date: July 23, 19 65, Driller: Joe Jobe County Tishomingo

(Name)

(1) Owner of Land: Mr. Hatcher

(Name)

Route 1, Burnsville, Miss.

(Address)

(2) Location: 1/4, 1/4, Sec. T R

3 miles SouthWest of Burnsville on Leedy Road.

(distance) (direction) (Nearest Town)

(3) Topography: Hilly

(Hilly) (Flat) (Level)

(4) Purpose of Well: Domestic

(Domestic Irrigation Municipal, Industrial, Other)

Description & Color of Materials Sand, Clay, Red Clay, Shell, etc.

Thick-ness Feet

Depth Feet

Mixed Red Clay & Sand

17

17

Blue Clay

60

77

Coffee Sand

36

113

Information upon completion of well:

(1) Diameter 8 inches.

(2) Total Depth 113 feet.

(3) Water Level 60 feet below top of ground.

(4) Cased to 93 ft., Size 4 inch

(5) Screen: Size 4", Length 20 ft. (Gravel Packed)


(6) Were any formations sealed against pollution?

yes, X no.

If YES depth of formation

Why

Drillers Remarks:

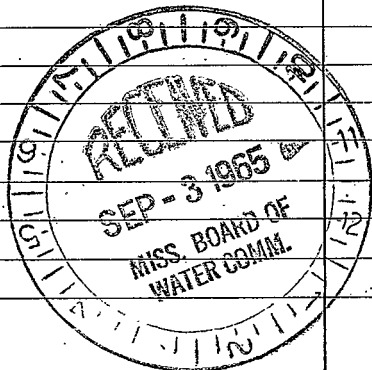

(Use Back Side)

Well No.

