

D 17

8-18-65

WATER WELL DRILLERS LOG

Date: Aug. 18, 1965, Driller: Joe Jobe County: Tishomingo

(Name)

(1) Owner of Land: Milton Vanderford

(Name)

Burnsville, Miss.

(Address)

(2) Location: 1/4, 1/4, Sec. T R

3 miles South of Burnsville

(distance)

(direction)

(Nearest Town)

(3) Topography: Hilly

(Hilly)

(Flat)

(Level)

(4) Purpose of Well: Domestic

(Domestic Irrigation, Municipal, Industrial, Other)

Description & Color of Materials Sand, Clay, Red Clay, Shell, etc.

Thick-ness Feet

Depth Feet

Yellow Clay	20	20
Blue Clay	80	100
Coffee Sand	36	136

Information upon completion of well:

(1) Diameter 4 inches.

(2) Total Depth 136 feet.

(3) Water Level 40 feet below top of ground.

(4) Cased to 20 ft, Size 4"


(5) Screen: Size, Length Open Hole Well

(6) Were any formations sealed against pollution? yes, no.

If YES depth of formation

Why

Drillers Remarks:

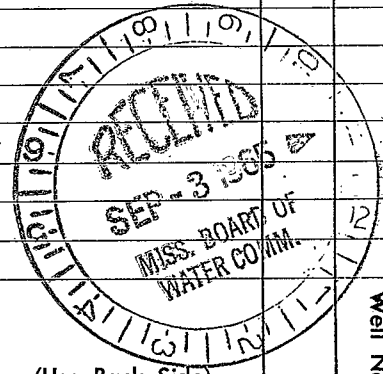

(Use Back Side)

Well No.

