

D 18

8-26-65

WATER WELL DRILLERS LOG

Date: Aug 26, 1965, Driller: Joe Jobe County Tishomingo


(1) Owner of Land: Jimmy Vanderford (Name) Burnsville, Miss. (Address)
(2) Location: 1/4, 1/4, Sec. T R, 3 1/2 miles South of Burnsville (distance) (direction) (Nearest Town)
(3) Topography: Hilly (Hilly) (Flat) (Level)
(4) Purpose of Well: Domestic (Domestic Irrigation Municipal, Industrial, Other)

Table with 3 columns: Description & Color of Materials (Sand, Clay, Red Clay, Shell, etc.), Thickness Feet, Depth Feet. Rows include Yellow Clay (20' 20'), Blue Clay (80' 100'), Coffee Sald (35' 135').

Information upon completion of well:

(1) Diameter 4 inches.
(2) Total Depth 135 feet.
(3) Water Level 50 feet below top of ground.
(4) Cased to 20ft, Size 4"
(5) Screen: Size, Length open Hole Well
(6) Were any formations sealed against pollution? yes, no.

If YES depth of formation
Why
Drillers Remarks:

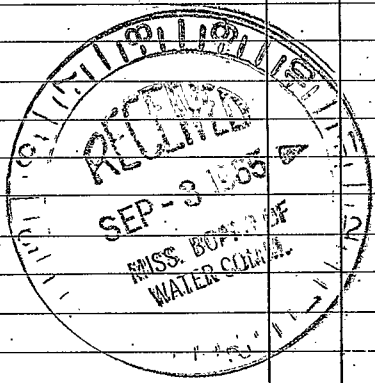

(Use Back Side)

Well No.

