

Tishomingo  
D 19  
7-67

MISSISSIPPI  
 BOARD OF WATER COMMISSIONERS  
 416 North State Street  
 Jackson, Mississippi 39201

WATER WELL DRILLERS LOG

July 3 1967 Bonds Plumbing & Drilling Co. Tishomingo  
 date well completed firm name county well located


LANDOWNER Charles Henderson  
Henderson St 1  
Burnsville Miss  
 (milling address)

description of formations encountered	from	to
<u>Sand + Clay</u>	<u>0'</u>	<u>12'</u>
<u>Blue Clay</u>	<u>12'</u>	<u>35'</u>
<u>Blue sand &amp; sandy clay</u>	<u>35'</u>	<u>69'</u>
<u>Blue Clay</u>	<u>6'</u>	<u>35'</u>
<u>Water Sand</u>	<u>35'</u>	<u>121'</u>

WELL LOCATION:  
 sec. 9 T. 3 N. R. 9 E.  
2 miles W of Burnsville  
 (distance) (direction) (nearest town)

WELL PURPOSE: Home  
 (home, irrigation, municipal, industrial)

- WELL COMPLETION DATA:
- diameter (inches) 4"
  - total depth (feet) 126 ft
  - static water level (feet) 35' below top of ground.
  - casing Black steel, 71 ft (material), (depth)  
4" (size) if telescope see back.
  - screen none (length) (depth to top)  
none (size) (material)
  - pump 1/3 (HP) 5 (yield gpm)  
Elect Jet (type power)
  - electric log no (yes or no)  
no (organization running log)
  - how well bottom plugged open

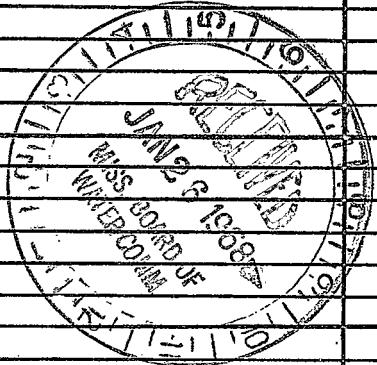

DRILLERS REMARKS:

If well telescopes please sketch and show depths.

GROUND LEVEL

2			

SECTION 900

Please indicate well location X.

ADDITIONAL INFORMATION

If more than one screen, show locations of each on sketch.