

71 5

CODED

CODED

Tishomingo
D22
5-69

MISSISSIPPI
BOARD OF WATER COMMISSIONERS
416 North State Street
Jackson, Mississippi 39201

WATER WELL DRILLERS LOG

5-22 1969 Faires Well Supply Tishomingo
date well completed firm name county well located

LANDOWNER: George Merrill
Route 1
Burnsville, Miss
(mailing address)

description of formations encountered	from	to
	<u>Red Clay mixed with Blue clay & sand</u>	<u>0</u>
<u>Fine Sand at 175'</u>		

WELL LOCATION:
sec. 15 T. 3 N. R. 9 E.
3 miles South of Burnsville
(distance) (direction) (nearest town)

WELL PURPOSE:
(Home, Irrigation, municipal, industrial)

WELL COMPLETION DATA:
(1) diameter (inches) 4"
(2) total depth (feet) 195
(3) static water level (feet) 125 below above top of ground.
(4) casing PVC 190
(material) (depth)
70 if telescope see back.
(size)
(5) screen 5' (length) (depth to top)
4" PVC
(size) (material)
(6) pump 1/2 6
(HP) (yield gpm)
Elec.
(type power)
(7) electric log no
(yes or no)
(organization running log)

(8) how well bottom plugged
Gravel Covered

DRILLERS REMARKS:
Alto


Sept. - 5 1969

MISS. Bd. of
WATER COMMISSIONERS

If well telescopes please
sketch and show depths.

7

GROUND LEVEL

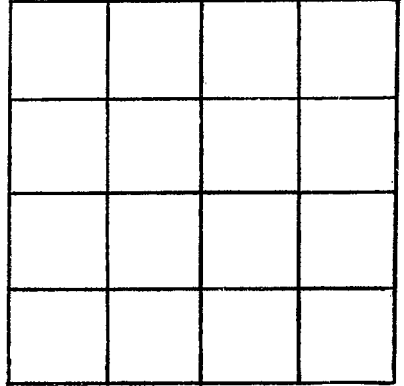

SECTION _____

Please indicate well location X.

ADDITIONAL INFORMATION

If more than one screen,
show locations of each on sketch.