

CODED

CODED

Tishomingo
D 23
9-4-69

MISSISSIPPI
BOARD OF WATER COMMISSIONERS
416 North State Street
Jackson, Mississippi 39201

WATER WELL DRILLERS LOG

9 - 4 1969 date well completed
FAIRES WELL SUPPLY firm name
TISHOMINGO county well located

LANDOWNER: Lex Whirley
Rt. 1, Burnsville
(mailing address)

description of formations encountered	from	to
Red sand & clay	0	135
Red Clay & Sand	0	30
Blue Clay	30	105
Gray Sand	105	135

WELL LOCATION:
sec. 10 3 N R 9 E
35 W
1 miles W. Burnsville
(distance) (direction) (nearest town)

WELL PURPOSE: home
(home, irrigation, municipal, industrial)

WELL COMPLETION DATA:

(1) diameter (inches) 4"

(2) total depth (feet) 135'

(3) static water level (feet) 90 ~~below~~ above top of ground.

(4) casing P.V.C. 125'
(material) (depth)

(size) if telescope see back.

(5) screen 5'
(length) (depth to top)
4" P.V.C.
(size) (material)

(6) pump 1 5
(HP) (yield gpm)

El ec.
(type power)

(7) electric log (yes or no)
(organization running log)


(8) how well bottom plugged

OCT 17 1969
MISS. BD. OF
WATER COMM.

DRILLERS REMARKS:

If well telescopes please sketch and show depths.

GROUND LEVEL

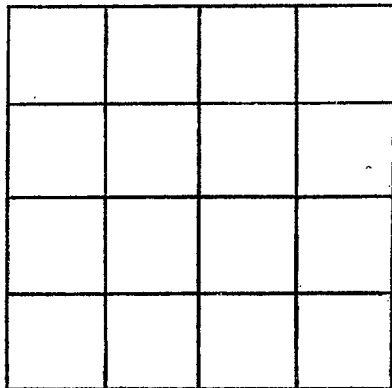

SECTION _____

Please indicate well location X.

ADDITIONAL INFORMATION

If more than one screen,
show locations of each on sketch.