

Tishomingo
 D 24
 4-29-66

MISSISSIPPI
 BOARD OF WATER COMMISSIONERS
 416 North State Street
 Jackson, Mississippi 39201

CODED

WATER WELL DRILLERS LOG

4-29-1966 Layne-Central Co. Tishomingo
 date well completed firm name county well located

LANDOWNER: Town of
 Burnsville, Mississippi

description of formations encountered	from	to
Sandy clay	0-13	
red sand	13-30	
gray sand	30-86	
gravel	86-106	
rock	106-107	
clay	107-108	
gravel	108-151	
red clay & gravel	151-155	
hard rock	155-157	
hard & soft stks rock	157-223	


(mailing address)

WELL LOCATION:
 sec 9 T 3 N R 9 E S W
 (distance) miles (direction) of (nearest town)

WELL PURPOSE:
 (home, irrigation, municipal, industrial)

WELL COMPLETION DATA:

- (1) diameter (inches) 8"
- (2) total depth (feet) 246'
- (3) static water level (feet) 20' below top of ground.
- (4) casing s. casing 208' (material) (depth)
 8" (size) if telescope see back.
- (5) screen 30' 214' (length) (depth to top)
 4" s. steel wire wrap (size) (material)
- (6) pump 7 1/2 HP 120 (type power) (yield gpm)
- (7) electric log (yes or no)
 (organization running log)
- (8) how well bottom plugged

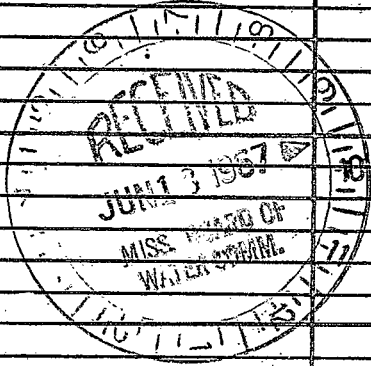


DRILLERS REMARKS: Elev = 465

7

If well telescopes please sketch and show depths.

GROUND LEVEL

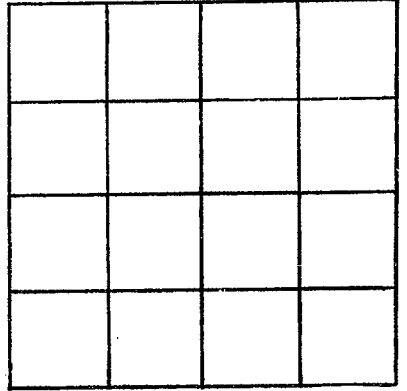

SECTION _____

Please indicate well location X.

ADDITIONAL INFORMATION

If more than one screen,
show locations of each on sketch.