

**TISHOMINGO**  
**D 32**  
**10-21-71**

MISSISSIPPI  
 BOARD OF WATER COMMISSIONERS  
 416 North State Street  
 Jackson, Mississippi 39201

WATER WELL DRILLERS LOG

**CODED**  
 county well located

10-21 1971 *Bonds Well Drilling*  
 date well completed firm name

LANDOWNER: *J. C. Lambert*  
*Brunsvilla Miss*  
 (mailing address)

description of formations encountered	from	to
<i>Red clay</i>	<i>0</i>	<i>16</i>
<i>Blue clay</i>	<i>16</i>	<i>143</i>
<i>Water sand</i>	<i>143</i>	<i>195</i>

WELL LOCATION:  
 sec 3 T 3 N R 9 E  
2 miles West of Brunsvilla  
 (distance) (direction) (nearest town)

WELL PURPOSE: None  
 (home, irrigation, municipal, industrial)


- WELL COMPLETION DATA:
- (1) diameter (inches) 4
  - (2) total depth (feet) 195
  - (3) static water level (feet) 100 below above top of ground.
  - (4) casing Steel, 21  
 (material) (depth)  
 (size) if telescope see back.
  - (5) screen None  
 (length) (depth to top)  
 (size) (material)
  - (6) pump None (yield gpm)  
 (type power)
  - (7) electric log No  
 (yes or no)  
 (organization running log)
  - (8) how well bottom plugged open

**CODED**  
 NOV 9 - 1971

DRILLERS REMARKS:

If well telescopes please sketch and show depths.

GROUND LEVEL

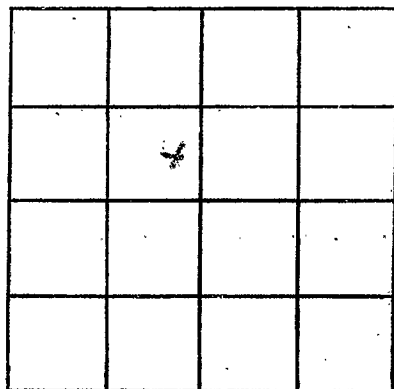

SECTION \_\_\_\_\_

Please indicate well location X.

ADDITIONAL INFORMATION

If more than one screen, show locations of each on sketch.