

CODER

MISSISSIPPI
 BOARD OF WATER COMMISSIONERS
 416 North State Street
 Jackson, Mississippi 39201

MAR 3 1972

Tishomingo
D 39
2-10-72

WATER WELL DRILLERS LOG
 Faires Well Supply

MISS. BD. OF
 Tishomingo

date well completed 19 firm name _____ county well located _____

LANDOWNER: Joe Hardwick
Rt. 2
Iuka, Miss.
 (mailing address)

description of formations encountered	from	to
	<u>Red clay & sand</u>	<u>0</u>
<u>Fine gray sand</u>	<u>135</u>	<u>155</u>

WELL LOCATION:
 sec. 25T3S R. 9E
3 miles S.E. of Burnsville
 (distance) (direction) (nearest town)

WELL PURPOSE:
 (home, irrigation, municipal, industrial)


- WELL COMPLETION DATA:
- (1) diameter (inches) 4"
 - (2) total depth (feet) 155
 - (3) static water level (feet) 100 below above top of ground.
 - (4) casing PVC 150'
 (material) (depth)
 - 0 If telescope see back.
 (size)
 - (5) screen 5' 150'
 (length) (depth to top)
4" PVC
 (size) (material)
 - (6) pump 1 1/2 Jet 5
 (HP) (yield gpm)
elec
 (type power)
 - (7) electric log NO
 (yes or no)
- (organization running log) _____
- (8) how well bottom plugged _____

CODER

DRILLERS REMARKS: _____

If well telescopes please sketch and show depths.

GROUND LEVEL

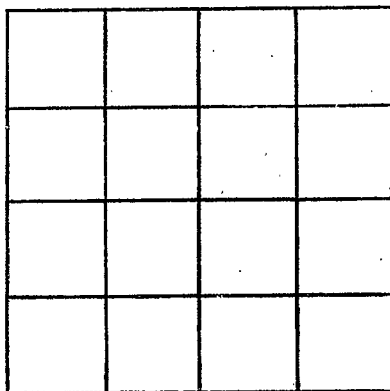

SECTION _____

Please indicate well location X.

ADDITIONAL INFORMATION

If more than one screen, show locations of each on sketch.