

NO W/L

Tishomingo  
~~D49~~  
11-20-71

MISSISSIPPI  
BOARD OF WATER COMMISSIONERS  
416 North State Street  
Jackson, Mississippi 39201  
**CODED**  
MAR 3 1972

WATER WELL DRILLERS LOG

11-20-71 19 Faires Well Supply Tishomingo  
date well completed firm name county well located

LANDOWNER: M.G. Sparks  
Rt. 2, Box 126D  
Iuka, Miss.  
(mailing address)

description of formations encountered	from to	
	from	to
Red clay & sand	0	148
Fine gray sand	148	168

WELL LOCATION:  
sec. 33 T. 3 R. 9 E  
1 1/2 miles W of Burnsville  
(distance) (direction) (nearest town)

WELL PURPOSE:  
(home) irrigation, municipal, industrial


- WELL COMPLETION DATA:
- (1) diameter (inches) 4"
  - (2) total depth (feet) 168
  - (3) static water level (feet) 130 below top of ground.
  - (4) casing PVC 168  
(material) (depth)  
(size) If telescope see back.
  - (5) screen 5' 163  
(length) (depth to top)  
4" PVC  
(size) (material)
  - (6) pump 1/2 10  
(HP) (yield gpm)  
(type power)
  - (7) electric log (yes of no)
  - (organization running log)
  - (8) how well bottom plugged

**CODED**

DRILLERS REMARKS:

If well telescopes please sketch and show depths.

GROUND LEVEL

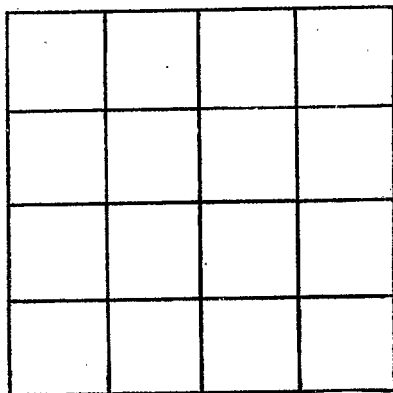

SECTION \_\_\_\_\_

Please indicate well location X.

ADDITIONAL INFORMATION

If more than one screen, show locations of each on sketch.