

E 8

7-65

WATER WELL DRILLERS LOG

Date: July, 1965, Driller: Joe Jobe County Tishomingo

(1) Owner of Land: Tick. County Fair Assn.  
 (Name)  
Suka, Miss.  
 (Address)

(2) Location: NE 1/4, SW 1/4, Sec. 26 T35R10E  
1 1/2 miles SW of Suka  
 (distance) (direction) (Nearest Town)  
nt Woodall Rd.

(3) Topography: Hilly  
 (Hilly) (Flat) (Level)

(4) Purpose of Well: Domestic  
 (Domestic Irrigation  
 Municipal, Industrial, Other)

Description & Color of Materials Sand, Clay, Red Clay, Shell, etc.	Thick- ness Feet	Depth Feet
<u>Brown Sand + Gravel</u>	<u>67</u>	<u>67</u>
<u>Fine Gravel</u>	<u>20</u>	<u>87</u>

Information upon completion of well:

(1) Diameter 8 inches.

(2) Total Depth 87 feet.

(3) Water Level 27 feet below top of ground.

(4) Cased to 67ft, Size 4"

(5) Screen: Size 2 1/2", Length 20ft  
Gravel Packed


(6) Were there any formations sealed against pollution?  
 \_\_\_\_\_ yes,  no.

If YES depth of formation \_\_\_\_\_

Why \_\_\_\_\_

Drillers Remarks: \_\_\_\_\_

alt 580'  
cor w/l 553'

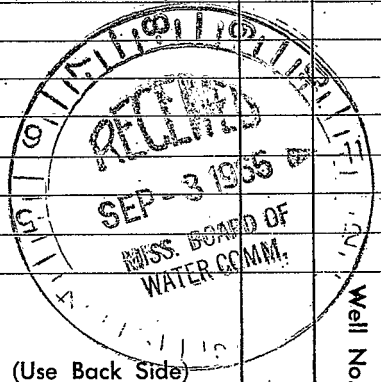

(Use Back Side)

Well No.

