

Leshomings
E9
7-21-69

MISSISSIPPI
BOARD OF WATER COMMISSIONERS
416 North State Street
Jackson, Mississippi 39201

CODED

CODED

WATER WELL DRILLERS LOG

July 21 1969 Hughes Well Drilling Lean
date well completed firm name county well located

LANDOWNER:
Clornel Sanders
Route 2 Delta Miss
(mailing address)

description of formations encountered	from	to
Dirt Sand	0	90
Gravel	90	100

WELL LOCATION:
sec. 11 T 3 S R 10 E
1 miles NORTH of IUKA
(distance) (direction) (nearest town)

WELL PURPOSE: IND.
(home, irrigation, municipal, industrial)

- WELL COMPLETION DATA:
- (1) diameter (inches) ~~6 1/2~~ 6 1/2
 - (2) total depth (feet) 130
 - (3) static water level (feet) 80 below top of ground.
 - (4) casing galv 130 (material) (depth)
(size) If telescope see back.
 - (5) screen (length) (depth to top)
(size) (material)
 - (6) pump 1 30 (HP) (yield gpm)
(type power)
 - (7) electric log (yes or no)
(organization running log)
 - (8) how well bottom plugged gravel

DRILLERS REMARKS:
Install 1 HP SUP PUMP
OPEN DISCHARGE
30 min run time.


SEP 3 1969

MISS. BD. OF
WATER COMM.



If well telescopes please
sketch and show depths.

GROUND LEVEL

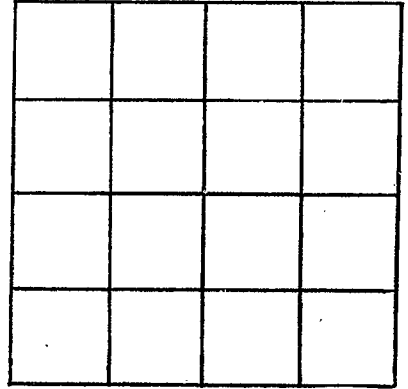

SECTION 11

Please indicate well location X.

ADDITIONAL INFORMATION

If more than one screen,
show locations of each on sketch.