

Lishomingo
E 10
9-69

MISSISSIPPI
BOARD OF WATER COMMISSIONERS
416 North State Street
Jackson, Mississippi 39201

CODED

CODED

WATER WELL DRILLERS LOG

date well completed 19 Hughes well Drilling firm name Lian county well located

LANDOWNER: Robert Akers
Route 2
Deuka miss
(mailing address)

description of formations encountered	from	to
<u>Red Clay</u>	<u>0</u>	<u>40</u>
<u>Sand</u>	<u>40</u>	<u>80</u>
<u>Gravel</u>	<u>80</u>	<u>130</u>

WELL LOCATION:
sec. 3 T. 3 S. R. 10 E.
4 miles N of Deuka
(distance) (direction) (nearest town)

WELL PURPOSE: Home
(home, irrigation, municipal, industrial)

- WELL COMPLETION DATA:
- (1) diameter (inches) 6 5/8
 - (2) total depth (feet) 130
 - (3) static water level (feet) 80 below above top of ground.
 - (4) casing Galv, 120,
(material) (depth)
(size) if telescope see back.
 - (5) screen _____ (length) _____ (depth to top)
(size) _____ (material)
 - (6) pump _____ (HP) _____ (yield gpm)
(type power)
 - (7) electric log _____ (yes or no)
(organization running log)
 - (8) how well bottom plugged _____


DRILLERS REMARKS:
owner furnish pump

SEP - 9 1969

WELLS RD. OF
BOARD OF
WATER COM.

If well telescopes please sketch and show depths.

GROUND LEVEL

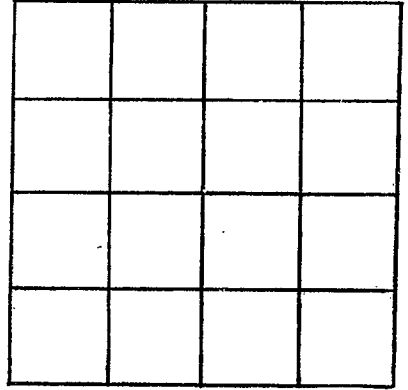

SECTION 3

Please indicate well location X.

ADDITIONAL INFORMATION

If more than one screen, show locations of each on sketch.