

*Lishomingo*  
*E 11*  
*9-69*

MISSISSIPPI  
 BOARD OF WATER COMMISSIONERS  
 416 North State Street  
 Jackson, Mississippi 39201

CODED

CODED

WATER WELL DRILLERS LOG

*Hughes Well Drilling Co*

date well completed 19 \_\_\_\_\_ firm name \_\_\_\_\_ county well located \_\_\_\_\_

LANDOWNER: *Skinner*  
*Route 2*  
*DeKa miss*  
 (mailing address)

description of formations encountered	from	to
<i>Sand</i>	<i>0</i>	<i>40</i>
<i>Gravel</i>	<i>40</i>	<i>60</i>

WELL LOCATION:  
 sec. *17* T *3* S R. *10* E  
*6* miles *W* of *DeKa*  
 (distance) (direction) (nearest town)

WELL PURPOSE: *Home Reservoir*  
 (home, irrigation, municipal, industrial)

- WELL COMPLETION DATA:
- (1) diameter (inches) *6 5/8*
  - (2) total depth (feet) *60*
  - (3) static water level (feet) *20* below above top of ground.
  - (4) casing *Galv.* *60*  
 (material) (depth)  
 (size) If telescope see back.
  - (5) screen \_\_\_\_\_  
 (length) (depth to top)  
 (size) (material)
  - (6) pump \_\_\_\_\_  
 (HP) (yield gpm)  
 (type power)
  - (7) electric log \_\_\_\_\_  
 (yes or no)  
 (organization running log)
  - (8) how well bottom plugged \_\_\_\_\_


DRILLERS REMARKS:  
*owner furnishes pump*

SEP - 9 1969

MISS. Bd. OF  
 WATER COMM.

If well telescopes please sketch and show depths.

GROUND LEVEL

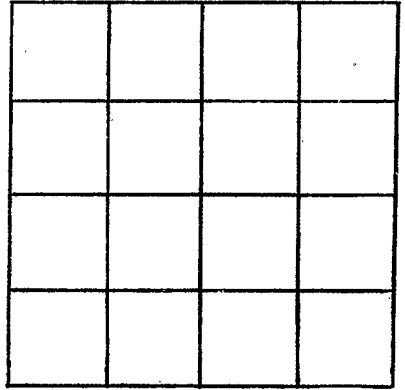

SECTION 17

Please indicate well location X.

ADDITIONAL INFORMATION

If more than one screen, show locations of each on sketch.