

CODED

MISSISSIPPI
BOARD OF WATER COMMISSIONERS
416 North State Street
Jackson, Mississippi 39201

Tishomingo
E 12
3-28-70

WATER WELL DRILLERS LOG

3-28 1970 Corinth well drilling Tishomingo
date well completed firm name county well located

LANDOWNER	description of formations encountered	from	to
Frank William Lukas Route 1	Sand & Gravel	0	40
	Gravel Red	40	45
	sand	45	60
	water sand	60	85

(mailing address)

WELL LOCATION:
sec. 17 T 3 N R 10 E
4 miles N.E. of Lukas
(distance) (direction) (nearest town)

WELL PURPOSE: Home
(home, irrigation, municipal, industrial)

- WELL COMPLETION DATA:
- (1) diameter (inches) 8
 - (2) total depth (feet) 85
 - (3) static water level (feet) _____ below/above top of ground.
 - (4) casing PVC 85' (material) (depth)
4" (size) if telescope see back.
 - (5) screen 20' 65 (length) (depth to top)
4 PVC Samed (size) (material)
 - (6) pump 3/4 11 (HP) (yield gpm)
Electric (type power)
 - (7) electric log (yes or no)
 - (organization running log)
 - (8) how well bottom plugged washed & covered

CODED


APR 24 1970

DRILLERS REMARKS:

MISS. BD. OF
WATER COMM.

If well telescopes please sketch and show depths.

GROUND LEVEL

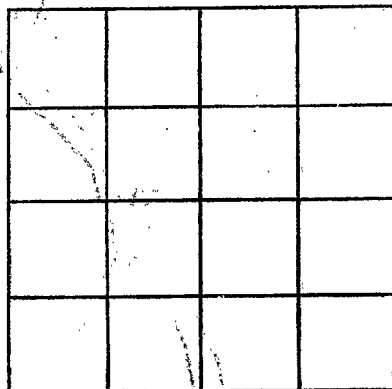

SECTION _____

Please indicate well location X.

ADDITIONAL INFORMATION

If more than one screen, show locations of each on sketch.