

TISH.
E 20
9-7-73

MISSISSIPPI
BOARD OF WATER COMMISSIONERS
416 North State Street
Jackson, Mississippi 39201

OCT 19 1973

WATER WELL DRILLERS LOG


CODED MISS. DEP.

9-7-73 date well completed 1973 Bond Well Drilling firm name Licking county well located

LANDOWNER:	description of formations encountered	from	to
Jimmy Works Burnsville, Miss. (mailing address)	Red clay yellow sand water sand	0 17 40	17 40 70
WELL LOCATION: sec 4 T 3 N R 10 E 5 miles NE of Burnsville (distance) (direction) (nearest town)			
WELL PURPOSE: Home (home, irrigation, municipal, industrial)			
WELL COMPLETION DATA: (1) diameter (inches) 4 (2) total depth (feet) 70 (3) static water level (feet) 27 below top of ground. (4) casing Plastic, 70 (material) (depth) if telescope see back. (5) screen Perforated (length) (depth to top) 4 (size) (material) (6) pump 3/4 10 (HP) (yield gpm) Submerg. (type power) (7) electric log NO (yes or no) (organization running log) (8) how well bottom plugged Plugged	CODED		
DRILLERS REMARKS:			

If well telescopes please sketch and show depths.

GROUND LEVEL

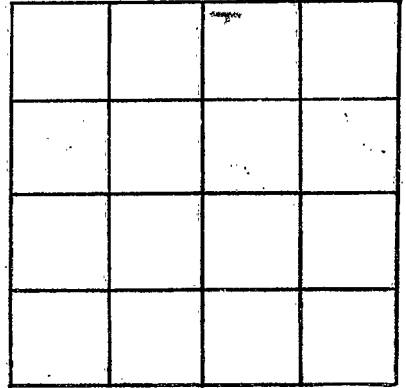

SECTION _____

Please indicate well location X.

ADDITIONAL INFORMATION

If more than one screen, show locations of each on sketch.