

E39

S

TISHOMINGO
E 639
8 84

MISSISSIPPI
 BOARD OF WATER COMMISSIONERS
 416 North State Street
 Jackson, Mississippi 39201

CODED

WATER WELL DRILLERS LOG

1984 Herndon Well & Supply, Inc. Tishomingo
 date well completed firm name county well located

LANDOWNER: Midway-Pleasant	description of formations encountered		from	to
Hill Water Association	Red Sandy Clay		0	15
Tuka, MS	Blue Sand & Clay Streaks		15	55
(mailing address)	Brown Sand		55	120
WELL LOCATION:	Brown Sand & Chaulk		120	185
sec. 25 T. 3 S. R. 10 E.	Blue Clay		185	190
2 miles SE of Tuka	Gravel		190	245
(distance) (direction) (nearest town)	Gray Clay		245	275
WELL PURPOSE: Municipal	Gravel & Shale Rock		275	320
(home, irrigation, municipal, industrial)	Sand		320	332
WELL COMPLETION DATA:	Pink Gumbo		332	350
(1) diameter (inches) 16 x 10"	Gravel & Shale Rock		350	378
(2) total depth (feet) 398'	Clay		378	382
(3) static water level (feet) 126 below top of ground.	Gravel & Shale Rock		382	412
(4) casing Steel 352' (material) (depth)	Pink Gumbo		412	595
16" (size) if telescope see back.	Chert & Shale Rock		595	620
(5) screen 51' 347' (length) (depth to top)	Gumbo		620	647
10" Stainless Steel (size) (material)	Rock		647	647
(6) pump 50 495 (HP) (yield gpm)				
electric (type power)				
(7) electric log yes (yes or no)				
MS Geo. Survey (organization running log)				
(8) how well bottom plugged 6" BWV @ 400'				
DRILLERS REMARKS:				

CODED

DEPT. OF NATURAL RESOURCES
 BUREAU OF LAND & WATER RESOURCES


SEP 24 1984

RECEIVED


①

If well telescopes please sketch and show depths.

GROUND LEVEL

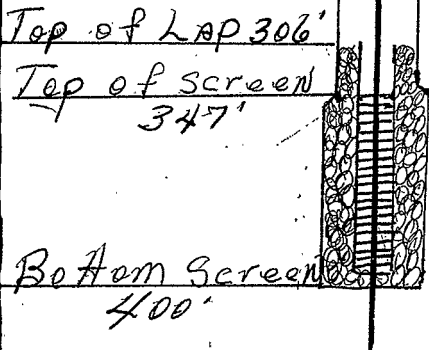

If more than one screen, show locations of each on sketch.

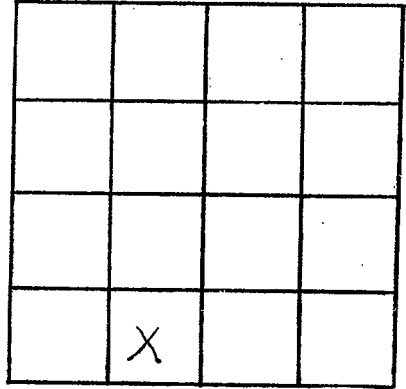

SECTION 25

Please indicate well location X.

ADDITIONAL INFORMATION

Multiple horizontal lines for additional information.