

18R

CODED

MISSISSIPPI
 BOARD OF WATER COMMISSIONERS
 416 North State Street
 Jackson, Mississippi 39201

WATER WELL DRILLERS LOG

TISA
 P 7
 9-25-68

Sept 25 1968 Hughes Well Drilling, Lumberton
 date well completed firm name county well located

LANDOWNER: Paul Martin Jr.
Route #71
Luka miss
 (mailing address)

description of formations encountered	from	to
Clay	0	20
11' sand	20	40
ground	40	90

WELL LOCATION:
 sec 20 T 3 N R. 11 E
2 miles East of Luka
 (distance) (direction) (nearest town)

WELL PURPOSE: Normal
 (home, irrigation, municipal, industrial)

- WELL COMPLETION DATA:
- diameter (inches) 5 5/8
 - total depth (feet) 90 ft
 - static water level (feet) 50 below above top of ground.
 - casing Galv., 87 ft
 (material) (depth)
 (size) if telescope see back.
 - screen None,
 (length) (depth to top)
 (size) (material)
 - pump _____
 (HP) (yield gpm)
 (type power)
 - electric log _____
 (yes or no)
 (organization running log)
 - how well bottom plugged _____

CODED


OCT 17 1968

MISS. DEP. OF WATER CONTROL

DRILLERS REMARKS:
200 pump will supply own

If well telescopes please sketch and show depths.

GROUND LEVEL

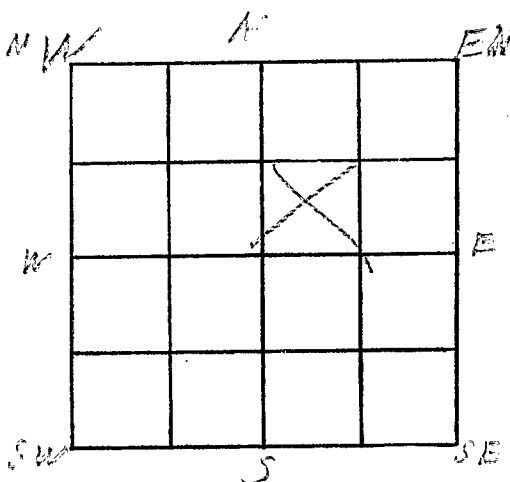

SECTION 20

Please indicate well location. X.

ADDITIONAL INFORMATION

If more than one screen, show locations of each on sketch.