

18R

TISH
R 8
9-26-68

MISSISSIPPI
BOARD OF WATER COMMISSIONERS
416 North State Street
Jackson, Mississippi 39201

CODED

WATER WELL DRILLERS LOG

Sept 26 1968 Hughes Well Drilling Tish.
date well completed firm name county well located

LANDOWNER: description of formations encountered from to

Rex Gene Woodruff
Rant to 1 Duke miss (mailing address)
Clay
Clay sand
Shard
0 25
25 40
40 95

WELL LOCATION:
sec 20 T 3 N R 11 E
2 miles miles East of Duke
(distance) (direction) (nearest town)

WELL PURPOSE: *Water*
(home, irrigation, municipal, industrial)

WELL COMPLETION DATA:

(1) diameter (inches) 5 5/8

(2) total depth (feet) 95

(3) static water level (feet) 60 below above top of ground.

(4) casing Galv. 90
(material) (depth)
(size) If telescope see back.

(5) screen _____
(length) (depth to top)
(size) (material)

(6) pump _____
(HP) (yield gpm)
(type power)

(7) electric log _____
(yes or no)
(organization running log)

(8) how well bottom plugged _____

CODED


OCT 17 1968

MISS. DEPT. OF WATER CONTROL

DRILLERS REMARKS:
Well supply own pump

If well telescopes please sketch and show depths.

GROUND LEVEL

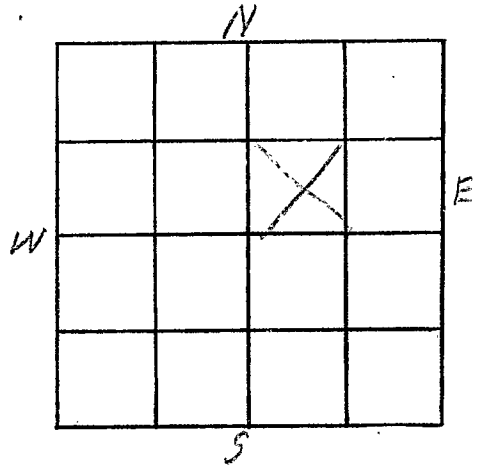

SECTION _____

Please indicate well location X.

ADDITIONAL INFORMATION

If more than one screen, show locations of each on sketch.