

18R

CODED

MISSISSIPPI  
 BOARD OF WATER COMMISSIONERS  
 416 North State Street  
 Jackson, Mississippi 39201

WATER WELL DRILLERS LOG

TISH  
 F 9  
 9-27-68

Sept 27 1968 Hughes Well Drilling Tish.  
 date well completed firm name county well located

LANDOWNER: Earl Martin  
 Route 11 1  
 Iuka Miss  
 (mailing address)

description of formations encountered	from	to
Clay	0	20
Shale	20	25

WELL LOCATION:  
 sec. 20 T. 3 N R. 11 E  
 2 miles East of Iuka  
 (distance) (direction) (nearest town)

CODED

WELL PURPOSE: Home  
 (home, irrigation, municipal, industrial)

WELL COMPLETION DATA:

(1) diameter (inches) 5 1/2

(2) total depth (feet) 75 ft

(3) static water level (feet) 40 below top of ground

(4) casing (material) Galv. Black (depth) 69 ft

(size) if telescope see back.

(5) screen (length) (depth to top) (size) (material)

(6) pump (HP) (yield gpm) (type power)

(7) electric log (yes or no) (organization running log)


(8) how well bottom plugged

Oct 17 1968  
 MISS. Bd. OF WATER COMMISSIONERS

DRILLERS REMARKS:  
 Well supply over pump

If well telescopes please sketch and show depths.

GROUND LEVEL

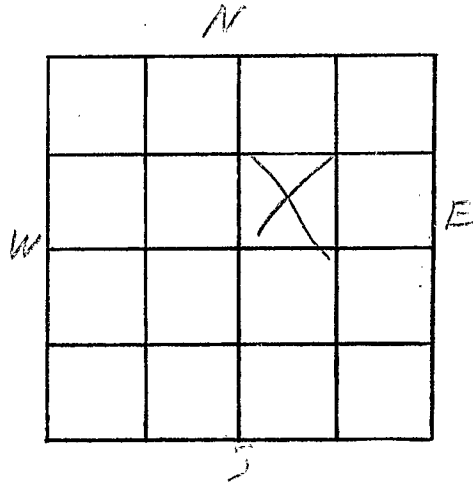

SECTION \_\_\_\_\_

Please indicate well location X.

ADDITIONAL INFORMATION

If more than one screen,  
show locations of each on sketch.