

18 Q

TISH
F 10
10-268

MISSISSIPPI
BOARD OF WATER COMMISSIONERS
416 North State Street
Jackson, Mississippi 39201

CODED

WATER WELL DRILLERS LOG

OCT 2 1968 Hughes well Drilling Co. Inc. *Tram.*
date well completed firm name county well located

LANDOWNER: J. R. Reed
Route #1
Dorsey Miss.
(mailing address) 36800

description of formations encountered	from	to
Gravel	0	13
capable Rock	13	16.5

WELL LOCATION:
sec. 23 T 2 N R 11 E
7 miles NORTH of Clarks
(distance) (direction) (nearest town)

WELL PURPOSE: HOME
(home, irrigation, municipal, industrial)

- WELL COMPLETION DATA:
- (1) diameter (inches) 4 1/2
 - (2) total depth (feet) 143
 - (3) static water level (feet) 128 12 below/above top of ground.
 - (4) casing GALV, 13 FT.
(material) (depth)
(size) if telescope see back.
 - (5) screen _____
(length) (depth to top)
(size) (material)
 - (6) pump _____
(HP) (yield gpm)
(type power)
 - (7) electric log _____
(yes or no)
(organization running log)
 - (8) how well bottom plugged _____

CODED


OCT 17 1968

MISS. Bd. OF WATER COMM.

DRILLERS REMARKS:
No pump but will own

If well telescopes please sketch and show depths.

GROUND LEVEL

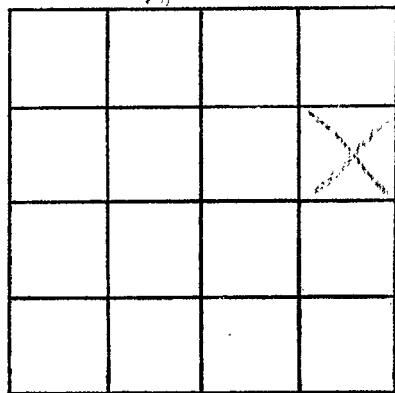

SECTION 23

Please indicate well location X.

ADDITIONAL INFORMATION

If more than one screen, show locations of each on sketch.