

182

Fishburne
7 11
10-28-68

MISSISSIPPI
BOARD OF WATER COMMISSIONERS
416 North State Street
Jackson, Mississippi 39201

CODED

WATER WELL DRILLERS LOG

Oct 28 1968 Hughes well Drilling Fish county well located

LANDOWNER:

Luka

description of formations encountered

from

to

Route # 3

Luka miss

(mailing address)

Clay
Gravel

0 20
20 200
230

WELL LOCATION:

sec. 015 T. 03 N R. 11 E
03 miles 0E of Luka
(distance) (direction) (nearest town)

WELL PURPOSE:

Home
(home, irrigation, municipal, industrial)

WELL COMPLETION DATA:

- (1) diameter (inches) 5 5/8
- (2) total depth (feet) 200
- (3) static water level (feet) 170 below top of ground
- (4) casing Recep galv 175
(material) (depth)
- (5) 0 if telescope see back.
(size)
- (6) screen _____
(length) (depth to top)

(size) (material)
- (7) pump 3/4 6
(HP) (yield gpm)
- Elec
(type power)
- (8) electric log NO
(yes or no)
- _____
(organization running log)
- (9) how well bottom plugged _____

CODED

NOV 25 1968
MISS. BD. OF
WATER COM.

DRILLERS REMARKS:

175' 5 5/8" Elec
40' 4" Plastic


If well telescopes please sketch and show depths.

GROUND LEVEL

5 5/8 175

4" plastic 40'

No screen

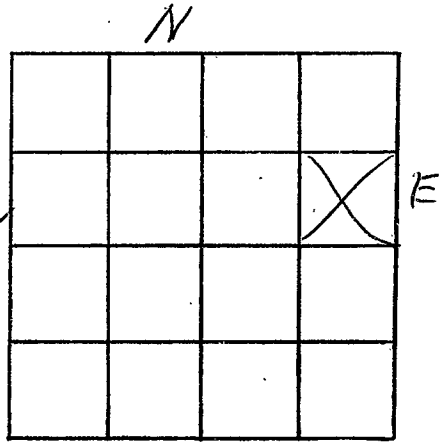

SECTION @ 15'

Please indicate well location X.

ADDITIONAL INFORMATION

If more than one screen, show locations of each on sketch.