

CODED

Lishornings  
712  
2-21-69

MISSISSIPPI  
BOARD OF WATER COMMISSIONERS  
416 North State Street  
Jackson, Mississippi 39201

WATER WELL DRILLERS LOG CODED

FEB 21 1969 Husbandry Drilling Lish  
date well completed firm name county well located

LANDOWNER: E.E. Mc. DOUGLE

description of formations encountered

from to

Route 3

Clay shale  
white rock

0 50  
50 70

Luka miss

(mailing address)

WELL LOCATION:

CODED

sec. 11 T 3 N R 11 E  
4 M miles (distance) W (direction) of LUKA (nearest town)

WELL PURPOSE:

(home, irrigation, municipal, industrial)

WELL COMPLETION DATA:

- (1) diameter (inches) 6 in
- (2) total depth (feet) 70 ft
- (3) static water level (feet) 20 below top of ground.
- (4) casing PLASTIC 65 ft (material) (depth)
- (size) if telescope see back.
- (5) screen (length) (depth to top) (size) (material)
- (6) pump (HP) (yield gpm) (type power)
- (7) electric log (yes or no) (organization running log)
- (8) how well bottom plugged Shallow

FEB 25 1969

MISS. BD. OF WATER COMMISSIONERS


DRILLERS REMARKS:

owner well permission  
owner present

(X)

If well telescopes please  
sketch and show depths.

GROUND LEVEL

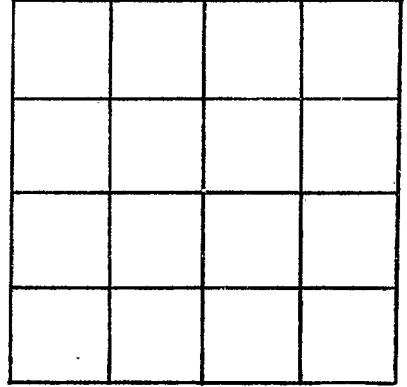

SECTION 11

Please indicate well location X.

ADDITIONAL INFORMATION

If more than one screen,  
show locations of each on sketch.