

Lishonings
713
5-3-69

MISSISSIPPI
BOARD OF WATER COMMISSIONERS
416 North State Street
Jackson, Mississippi 39201

CODED

WATER WELL DRILLERS LOG

May 3 - 69 19 Hughes Well Drilling Lishonings
date well completed firm name county well located

LANDOWNER: Eod Hogery
Route 3
Delta mess
(mailing address)

description of formations encountered	from	to
	<u>Gravel</u>	<u>0</u>

WELL LOCATION:
sec. 11 T. 3 N. R. 12 E
4 miles N-E of Delta
(distance) (direction) (nearest town)
Mill Creek Road

WELL PURPOSE: TRAILER PARK
(home, irrigation, municipal, industrial)

WELL COMPLETION DATA:

(1) diameter (inches) 6 1/4

(2) total depth (feet) 50

(3) static water level (feet) 5 1/2 below top of ground. above

(4) casing Galv 45
(material) (depth)
 if telescope see back.
(size)

(5) screen
(length) (depth to top)

(size) (material)

(6) pump
(HP) (yield gpm)

(type power)

(7) electric log
(yes or no)

(organization running log)

(8) how well bottom plugged

MAY 12 1969


DRILLERS REMARKS:
Owner will furnish
orient pump

MISS. BD. OF
WATER COMM.

(X)

If well telescopes please sketch and show depths.

GROUND LEVEL

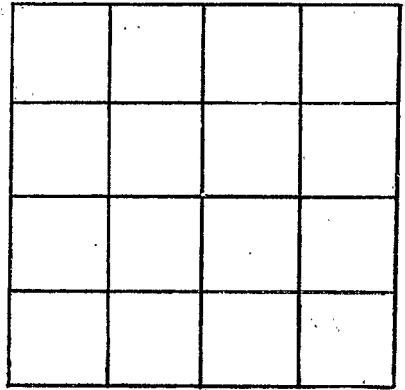

SECTION 11

Please indicate well location X.

ADDITIONAL INFORMATION

If more than one screen, show locations of each on sketch.