

Leshomings
7 140
5-20-69

MISSISSIPPI
 BOARD OF WATER COMMISSIONERS
 416 North State Street
 Jackson, Mississippi 39201

CODED

WATER WELL DRILLERS LOG

may 20 1969 Hughes well Drilling Lisa
 date well completed firm name county well located

LANDOWNER:	description of formations encountered	from	to
<u>D.L. MEDLEY</u>			
<u>D.L. MEDLEY</u>			
<u>ROUT 3 Iuka miss</u> (mailing address)	<u>clay</u> <u>Shovel</u>	<u>0</u> <u>20</u>	<u>20</u> <u>120</u>

WELL LOCATION:
 sec 7 T 3 S R 11 E
2 miles N of IUKA
 (distance) (direction) (nearest town)

WELL PURPOSE: Home
 (home, irrigation, municipal, industrial)

WELL COMPLETION DATA:

(1) diameter (inches) 6 1/4

(2) total depth (feet) 120

(3) static water level (feet) 70 below
 top of ground.

(4) casing Galv 120
 (material) (depth)

_____ if telescope see back.
 (size)

(5) screen no
 (length) (depth to top)

_____ (size) _____ (material)

(6) pump 1/2 500
 (HP) (yield gpm)

220
 (type power)

(7) electric log _____
 (yes or no)

_____ (organization running log)

(8) how well bottom plugged Shovel


DRILLERS REMARKS:

JUN 19 1969

MISS. Bd. OF
 WATER COMM.

If well telescopes please
sketch and show depths.

GROUND LEVEL

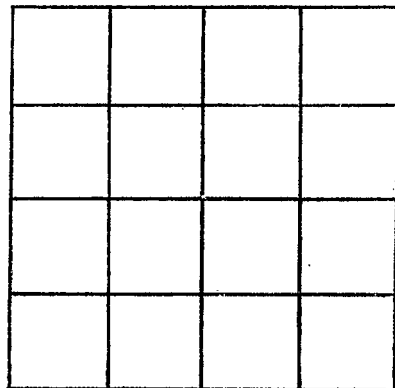

SECTION 2

Please indicate well location X.

ADDITIONAL INFORMATION

If more than one screen,
show locations of each on sketch.