

Leshmings
7-15
9-69

MISSISSIPPI
 BOARD OF WATER COMMISSIONERS
 416 North State Street
 Jackson, Mississippi 39201

CODED

CODED

WATER WELL DRILLERS LOG

Hughes well Drilling Lish

date well completed 19

firm name

county well located

LANDOWNER: Raymond morin

description of formations encountered

from

to

1416 W Crestwood Dr

Gravel

0

10

Memphis Tenn

Red clay

10

70

(mailing address)

Gravel

70

100

WELL LOCATION:

sec. 14 T 3 N R 11 E
 S W
4 miles E of IUKA
 (distance) (direction) (nearest town)

WELL PURPOSE: HOME
 (home, irrigation, municipal, industrial)

WELL COMPLETION DATA:

- (1) diameter (inches) 6 1/4
- (2) total depth (feet) 100
- (3) static water level (feet) 50 below above top of ground.
- (4) casing Galv., 90,
 (material) (depth)
 (size) If telescope see back.
- (5) screen _____,
 (length) (depth to top)
 (size) (material)
- (6) pump _____,
 (HP) (yield gpm)
 (type power)
- (7) electric log _____
 (yes or no)
 (organization running log)
- (8) how well bottom plugged _____


DRILLERS REMARKS:

MISS. DD
 WATER COM

9-15-69

If well telescopes please sketch and show depths.

GROUND LEVEL

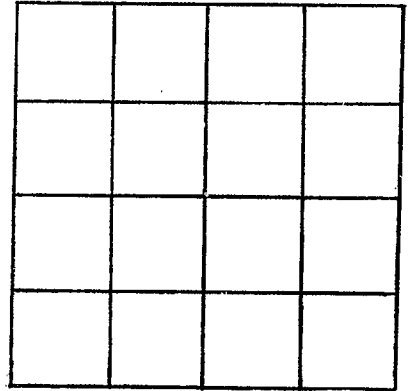

SECTION 14

Please indicate well location X.

ADDITIONAL INFORMATION

If more than one screen,
show locations of each on sketch.