

TISH
648
10-17-74

MISSISSIPPI
BOARD OF WATER COMMISSIONERS
416 North State Street
Jackson, Mississippi 39201

CODED

WATER WELL DRILLERS LOG

10-17 1974 Bonds Well Drilling Lishamingo
date well completed firm name county well located

LANDOWNER: John High
Lishamingo
Miss.
(mailing address)

description of formations encountered	from	to
Red clay	0	23
Yellow Sand	23	76
White Sand	76	120

WELL LOCATION:
sec. 10 T 4 N R 10 E 15A
2 miles N of Midway
(distance) (direction) (nearest town)

WELL PURPOSE: Home
(home, irrigation, municipal, industrial)

- WELL COMPLETION DATA:
- (1) diameter (inches) 4"
 - (2) total depth (feet) 120
 - (3) static water level (feet) 32 ^{below} _{above} top of ground.
 - (4) casing Plastic, 120,
(material) (depth)

If telescope see back.
(size)
 - (5) screen Perforated
(length) (depth to top)

(size) (material)
 - (6) pump Hand own,
(HP) (yield gpm)

(type power)
 - (7) electric log NO
(yes or no)

(organization running log)
 - (8) how well bottom plugged Slugged


CODED

DRILLERS REMARKS:

RECORDED
MAR 13 1975

If well telescopes please sketch and show depths.

GROUND LEVEL

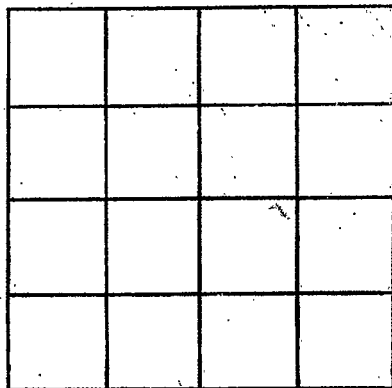

SECTION _____

Please indicate well location X.

ADDITIONAL INFORMATION

If more than one screen,
show locations of each on sketch.