

Lishomingo  
 G 49  
 9-1-75

MISSISSIPPI  
 BOARD OF WATER COMMISSIONERS  
 416 North State Street  
 Jackson, Mississippi 39201

CODED

WATER WELL DRILLERS LOG

9-1 1975 Birdsall Drilling Lishomingo  
 date well completed firm name county well located

LANDOWNER: <u>Gen Mc Lane</u>	description of formations encountered	from	to
<u>Lishomingo, Miss.</u>			
(mailing address)	<u>Red clay</u>	<u>0</u>	<u>20</u>
	<u>Yellow Sand</u>	<u>20</u>	<u>96</u>
	<u>Water Sand</u>	<u>96</u>	<u>150</u>

WELL LOCATION:  
 sec 25 T 4 N R 9 E <sup>13B</sup>  
2 miles N of Paducah  
 (distance) (direction) (nearest town)

CODED

WELL PURPOSE: Home  
 (home, irrigation, municipal, industrial)


- WELL COMPLETION DATA:
- (1) diameter (inches) 4"
  - (2) total depth (feet) 150'
  - (3) static water level (feet) 100 <sup>below</sup> top of ground. plastic
  - (4) casing Perforated 150  
 (material) (depth)
  - (size) if telescope see back.
  - (5) screen Perforated  
 (length) (depth to top)
  - (size) (material)
  - (6) pump 3/4 10  
 (HP) (yield gpm)
  - Elect.  
 (type power)
  - (7) electric log NO  
 (yes or no)
  - (organization running log)
  - (8) how well bottom plugged Plugged

DRILLERS REMARKS:

RECEIVED  
 SEP 24 1975

If well telescopes please sketch and show depths.

GROUND LEVEL

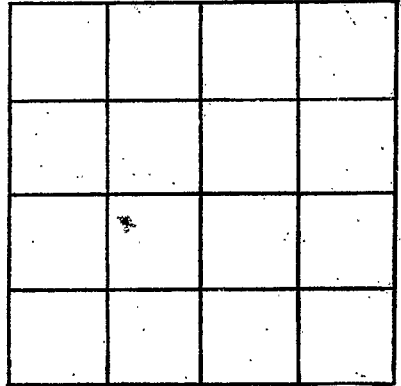

SECTION \_\_\_\_\_

Please indicate well location X.

ADDITIONAL INFORMATION

If more than one screen, show locations of each on sketch.