

Lithomings
H R on H
2000

MISSISSIPPI
 BOARD OF WATER COMMISSIONERS
 416 North State Street
 Jackson, Mississippi 39201

WATER WELL DRILLERS LOG

5-15 1984 *Knob Drilling Co.* *Lithomings*
 date well completed firm name county well located

LANDOWNER *Bob Lambert*
Routed by 95
Suba, MS. 38852
 (mailing address)

description of formations encountered	from	to
<i>sand + gravel</i>	<i>1</i>	<i>105</i>

WELL LOCATION:
 sec. *31* T *4* S R *11* E
 miles *North Belmont*
 (distance) (direction) (nearest town)

WELL PURPOSE: *Home*
 (home, irrigation, municipal, industrial)


- WELL COMPLETION DATA:
- (1) diameter (inches) *6 in*
 - (2) total depth (feet) *105 ft*
 - (3) static water level (feet) *75* below above top of ground.
 - (4) casing *iron* *105*
 (material) (depth)
6 in if telescope see back.
 (size)
 - (5) screen _____
 (length) (depth to top)
 (size) (material)
 - (6) pump _____ *30*
 (HP) (yield gpm)
 (type power)
 - (7) electric log *No*
 (yes or no)
 (organization running log)
 - (8) how well bottom plugged *gravel*

DRILLERS REMARKS:

DEPT. OF NATURAL RESOURCES
 BUREAU OF LAND & WATER RESOURCES
 JUN 21 1984
 RECEIVER

If well telescopes please sketch and show depths.

GROUND LEVEL

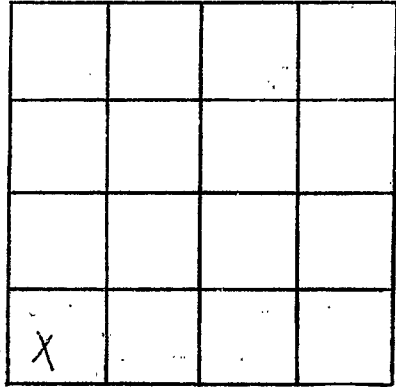

SECTION _____

Please indicate well location X.

ADDITIONAL INFORMATION

Oppast Mt. Vernon,
Cherokee - Caber Right
Road - 1/2 mi. to Right
county line - 1/2 mi. to
Road - 1/2 mi. to
House - 1/2 mi. to R.

If more than one screen,
show locations of each on sketch.