

13B

MISSISSIPPI BOARD OF WATER COMMISSIONERS  
416 North State Street  
Jackson, Mississippi 39201

**CODED**

WATER WELL DRILLERS LOG

Tishomingo  
J 10  
10-23-68

Oct 23 1968 Miller Drilling Co TISHOMINGO  
date well completed firm name county well located

LANDOWNER:  
PADEN WATER DISC.  
  
(mailing address)

description of formations encountered	from	to
<u>BROWN SAND</u>	<u>0</u>	<u>40</u>
<u>GRAY sandy clay</u>	<u>40</u>	<u>60</u>
<u>GRAY sand</u>	<u>60</u>	<u>145</u>
<u>blue sandstone rock</u>	<u>145</u>	<u>155</u>
<u>Small multi-colored gravel</u>	<u>155</u>	<u>181</u>

WELL LOCATION:  
sec 8 T. S NE R. 10 E  
DOWN TOWN PADEN  
miles of (distance) (direction) (nearest town)

WELL PURPOSE: municipal  
(home, irrigation, municipal, industrial)

well FLOWED  
80 gpm

- WELL COMPLETION DATA:
- (1) diameter (inches) 8 1/4
  - (2) total depth (feet) 181
  - (3) static water level (feet) 20' <sup>EST</sup> below above top of ground.
  - (4) casing (material) (depth) (size) If telescope see back.
  - (5) screen (length) (depth to top) (size) (material)
  - (6) pump (HP) (yield gpm) (type power)
  - (7) electric log NO (yes or no)
  - (8) how well bottom plugged

Fe 10.0 ppm  
pH 6.2  
Chloride 25 ppm  
Hardness & grains  
  
According to Geo. Cook  
this water may be used  
for the City of Tishomingo,  
It would require treatment  
11/21/68 J. Lewis Rees


NOV 19 1968

MISS. BD. OF  
WATER COMM.

DRILLERS REMARKS:  
Test well ONLY  
See Leland Cook /  
Log

If well telescopes please  
sketch and show depths.

GROUND LEVEL

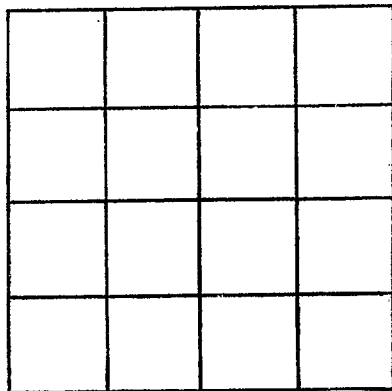

SECTION 8

Please indicate well location X.

ADDITIONAL INFORMATION

If more than one screen,  
show locations of each on sketch.