

CODED

MISSISSIPPI BOARD OF WATER COMMISSIONERS
416 North State Street Next To Pennington House
Jackson, Mississippi 39201

Well #2

WATER WELL DRILLERS LOG

TISHOMINGO

J62

5-1-78

May 1, 1978
date well completed

Wilson's Inc.
firm name

Tishomingo
county well located

LANDOWNER:	description of formations encountered	from	to
Town of Tishomingo City Hall (mailing address)			
	Red Clay	13	19
	Sand	19	35
	Clay & Rock	35	41
	Sand w/ clay streaks	41	55
	Small Rock & Sand	55	60
	Sand	60	67
	Clay & Rock	67	80
	Blue Clay	80	84
	Rock & Gravel	84	87
	Sand	87	100
	Sand	100	123
<p>WELL LOCATION: 1/2 - 1/4 mile E. of Tishomingo, MS sec. 25 T 5 N R 10 E 1/4 miles SE of (nearest town)</p> <p>WELL PURPOSE: Municipal (home, irrigation, municipal, industrial)</p> <p>WELL COMPLETION DATA:</p> <p>(1) diameter (inches) 10</p> <p>(2) total depth (feet) 120</p> <p>(3) static water level (feet) 71.6' below top of ground.</p> <p>(4) casing PVC (material), (depth) If telescope see back. (size)</p> <p>(5) screen 20 (length), 100' (depth to top) 6" (size), PVC (material)</p> <p>(6) pump 5 (HP), 102 (yield gpm) Elec (type power)</p> <p>(7) electric log (yes or no) (organization running log)</p> <p>(8) how well bottom plugged PVC cap</p>			
<p>DRILLERS REMARKS:</p>			

CODED

RECEIVED


JUN - 1 1978

MISS. BD. OF WATER COMM

⊗

If well telescopes please sketch and show depths.

GROUND LEVEL

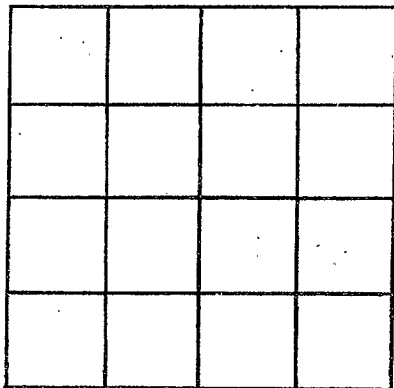

SECTION _____

Please indicate well location X.

ADDITIONAL INFORMATION

If more than one screen, show locations of each on sketch.