

TISHOMINGO  
 J65.  
 5-1-78

MISSISSIPPI  
 BOARD OF WATER COMMISSIONERS  
 416 North State Street  
 Jackson, Mississippi 39201

Well #3  
 Twitty Property

WATER WELL DRILLERS LOG **CODED**

May 1 1978 Wilson's Inc. Tishomingo  
 date well completed firm name county well located

LANDOWNER:  
 Town of Tishomingo  
 City Hall  
 (mailing address)

WELL LOCATION:  
 sec. 5 T. 5 N. R. 10 E.  
 1/2 - 1/4 E. of Tishomingo  
 3/4 miles S.S. of Hwy #3  
 (distance) (direction) (nearest town)  
 on Highway 12nd Rd.

WELL PURPOSE:  
 (home, irrigation, municipal, industrial)

WELL COMPLETION DATA:

(1) diameter (inches) 10  
 (2) total depth (feet) 89  
 (3) static water level (feet) 54 below top of ground.  
 (4) casing PVC, 69 (material) (depth)  
 (size) if telescope see back.  
 (5) screen 20' 69 (length) (depth to top)  
 6" PVC (size) (material)  
 (6) pump 2 55 (HP) (yield gpm)  
 Elec. (type power)  
 (7) electric log (yes or no)  
 (organization running log)  
 (8) how well bottom plugged PVC, G.P.A.

description of formations encountered	from	to
Red Sand & Clay	0	10
Blue Sand	10	20
" "	20	30
" "	30	40
" "	40	56
Rock	56	57
Clay	57	60
Clay & Gravel	60	65
White Sand	65	80
" "	80	90
Rock	90	93

**CODED**

**RECEIVED**

JUN - 1 1978


MISS. BD. OF WATER COMM.

DRILLERS REMARKS:

7

If well telescopes please sketch and show depths.

GROUND LEVEL

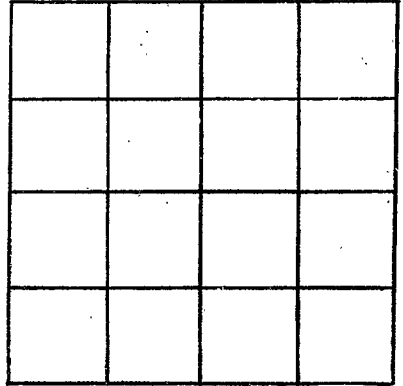

SECTION \_\_\_\_\_

Please indicate well location X.

ADDITIONAL INFORMATION

If more than one screen, show locations of each on sketch.