

18 Q

MISSISSIPPI
BOARD OF WATER COMMISSIONERS
416 North State Street
Jackson, Mississippi 39201

CODED

WATER WELL DRILLERS LOG

Lidowang
K 2
10-15-68

0 00 15 1968 Hubert Well Drilling Lian
date well completed firm name county well located

LANDOWNER: AB CAMPBELL
Route
Winningo Miss
(mailing address)

description of formations encountered	from	to
<u>Clay</u>	<u>0</u>	<u>20</u>
<u>shale</u>	<u>20</u>	<u>86</u>

WELL LOCATION:
sec 3 T 6 N R 11 E
6 miles S of Lian
(distance) (direction) (nearest town)

WELL PURPOSE: home
(home, irrigation, municipal, industrial)

- WELL COMPLETION DATA:
- (1) diameter (inches) 5 7/8
 - (2) total depth (feet) 85
 - (3) static water level (feet) 50 below top of ground.
 - (4) casing Galv 85
(material) (depth)
 - 4 If telescope see back.
(size)
 - (5) screen NONE
(length) (depth to top)
 - (size) (material)
 - (6) pump _____
(HP) (yield gpm)
 - (type power)
 - (7) electric log _____
(yes or no)
 - (organization running log)
 - (8) how well bottom plugged _____

CODED


NOV 25 1968

MISS. BD. OF
WATER COM.

DRILLERS REMARKS:
Supply own pump

If well telescopes please sketch and show depths.

GROUND LEVEL

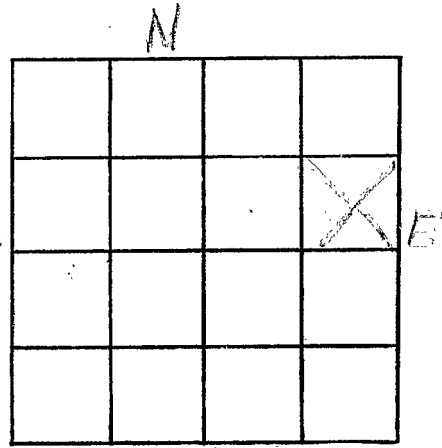

SECTION 2

Please indicate well location X.

ADDITIONAL INFORMATION

If more than one screen, show locations of each on sketch.