

Tishomingo  
K 3  
7-69

MISSISSIPPI  
BOARD OF WATER COMMISSIONERS  
416 North State Street  
Jackson, Mississippi 39201

CODED

WATER WELL DRILLERS LOG

July 4 19 9 Hughes Well Drilling Lian  
date well completed firm name county well located

LANDOWNER: B L Kuesel  
Rout 1  
Belmont Miss  
(mailing address)

description of formations encountered	from	to
Dirte	0	20
Gravel	20	50
Sand Rock	50	95
Asphalt Rock	95	270
		270

WELL LOCATION:  
sec. 23 T 5 N R 11 E  
1/4 miles N of BLOODY SPRINGS  
(distance) (direction) (nearest town)

WELL PURPOSE:  
(home, irrigation, municipal, industrial)

WELL COMPLETION DATA:

(1) diameter (inches) 6 1/4  
(2) total depth (feet) 270  
(3) static water level (feet) 100 below top of ground. no Reservoir above  
(4) casing Galva 50 (material) (depth)  
(size) if telescope see back.  
(5) screen (length) (depth to top)  
(size) (material)  
(6) pump (HP) (yield gpm)  
(type power)  
(7) electric log (yes or no)  
(organization running log)  
(8) how well bottom plugged


DRILLERS REMARKS:  
owner well furnish pump

JUL 14 1969  
Miss. Bd. of Water Comm.  
Jackson, Miss.

(X)

If well telescopes please sketch and show depths.

GROUND LEVEL

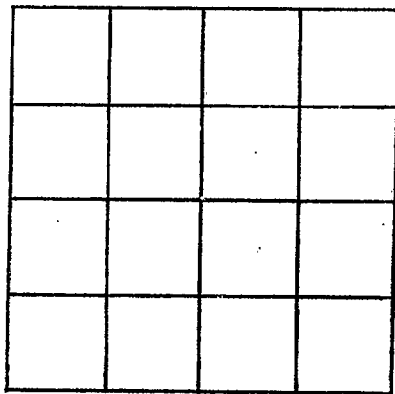

SECTION \_\_\_\_\_

Please indicate well location X.

ADDITIONAL INFORMATION

If more than one screen, show locations of each on sketch.