

L 11

Never Permitted

8-15-62

WATER WELL DRILLERS LOG

Date: 8-15, 1962, Driller: OTTIS Webb, JR. County TISHOMINGO

(Name)

Tishomingo

(1) Owner of Land: CITY OF BELMONT  
(Name)  
CITY OF BELMONT  
(Address)

(2) Location: 1/4, 1/4, Sec.     T.     R.      
    miles of      
(distance) (direction) (Nearest Town)

(3) Topography:  (Hilly)  (Flat)  (Level)

(4) Purpose of Well: MUNICIPAL  
(Domestic Irrigation, Municipal, Industrial, Other)

Description & Color of Materials Sand, Clay, Red Clay, Shell, etc.	Thick-ness Feet	Depth Feet
<u>CLAY</u>	<u>0</u>	<u>10</u>
<u>SAND + FINE GRAVEL</u>	<u>10</u>	<u>24</u>
<u>FINE SAND + GRAVEL</u>	<u>24</u>	<u>38</u>
<u>CLAY AND SAND</u>	<u>38</u>	<u>78</u>
<u>HARD ROCK</u>	<u>78</u>	<u>79</u>
<u>SAND AND CLAY</u>	<u>79</u>	<u>90</u>
<u>WITH SHELL INTERMIXED</u>		
<u>HARD ROCK</u>	<u>90</u>	<u>91</u>
<u>GRAVEL WITH</u>	<u>91</u>	<u>120</u>
<u>STREAKS OF SAND</u>		
<u>SAND WITH SMALL</u>	<u>120</u>	<u>167</u>
<u>AMOUNT OF GRAVEL</u>		
<u>ROCK</u>	<u>167</u>	


Information upon completion of well:

- (1) Diameter 6 inches.
- (2) Total Depth 167 feet.
- (3) Water Level     feet below top of ground.
- (4) Cased to 107' 10", Size 6"
- (5) Screen: Size 4", Length 30'
- (6) Were any formations sealed against pollution?  
    yes,     no.

If YES depth of formation    

Why    

Drillers. Remarks:    

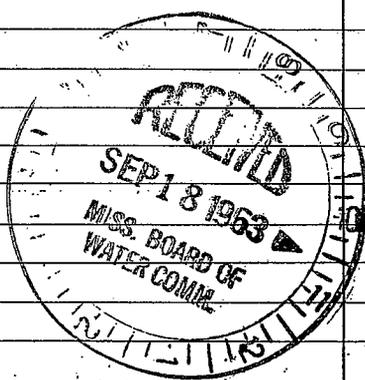

(Use Back Side)

Well No.

(X)

1912

1913

1914

1945