

L-17

18Q

Zishong
L-17
10-23-68

MISSISSIPPI
BOARD OF WATER COMMISSIONERS
416 North State Street
Jackson, Mississippi 39201

CODED

WATER WELL DRILLERS LOG

Oct 23 1968 Hughes Well Drill Lica
date well completed firm name county well located

LANDOWNER: Paul Horn

description of formations encountered

from to

Paul #

Clay

0 20

Belmont miss (mailing address)

sand clay

20 50

limestone

50 102

sand rock

102 122

blue mud

122 125

WELL LOCATION:

sec. 4 T. 6 R. 11 E
Cloudy Springs (distance) miles East of Fish (direction) (nearest town)

WELL PURPOSE: Normal (home, irrigation, municipal, industrial)

WELL COMPLETION DATA:

(1) diameter (inches) 5 1/4
(2) total depth (feet) 125-25
(3) static water level (feet) 80 below top of ground above

(4) casing Belmont 102 (material) (depth)

(size) if telescope see back.

(5) screen NONE (length) (depth to top)

(size) (material)

(6) pump (HP) (yield gpm)

(type power)

(7) electric log (yes or no)

(organization running log)

(8) how well bottom plugged

DRILLERS REMARKS:

Will supply own pump


CODED

NOV 25 1968

MISS. REG. OFF. WATER COMMISSIONERS

If well telescopes please sketch and show depths.

GROUND LEVEL

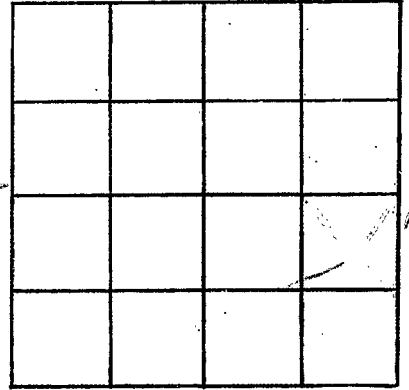

SECTION 4

Please indicate well location X.

ADDITIONAL INFORMATION

If more than one screen, show locations of each on sketch.