

CODED

MISSISSIPPI  
BOARD OF WATER COMMISSIONERS  
416 North State Street  
Jackson, Mississippi 39201

*Lisboning*  
~~AL 22~~  
4-11-69

WATER WELL DRILLERS LOG

4-11-1969 *Hughes well Drilling* *Lisboning*  
date well completed firm name county well located

| LANDOWNER: <i>Hollis Roads</i><br><i>Route 1</i>  | description of formations encountered | from | to         |
|---|---------------------------------------|------|------------|
| <i>Belmont miss</i><br>(mailing address)  | <i>Clay Shell</i><br><i>Rock</i>      | 0    | 100<br>100 |
| WELL LOCATION:<br>sec. <u>4</u> T. <u>6</u> S. R. <u>11</u> (E)<br><u>1/4</u> miles W of <i>Bloody Springs</i><br>(distance) (direction) (nearest town) |                                       |      |            |
| WELL PURPOSE: <i>home</i><br>(home, irrigation, municipal, industrial)  |                                       |      |            |
| WELL COMPLETION DATA:   |                                       |      |            |
| (1) diameter (inches) <u>6 1/4</u>  |                                       |      |            |
| (2) total depth (feet) <u>100</u>   |                                       |      |            |
| (3) static water level (feet) <u>50</u> below above top of ground.  |                                       |      |            |
| (4) casing <u><i>Galv</i></u> , <u>100</u> ,<br>(material) (depth)<br><u>no</u> if telescope see back.<br>(size)  |                                       |      |            |
| (5) screen <u>no</u> , <u>no</u><br>(length) (depth to top)<br><u>no</u> , <u>no</u><br>(size) (material)   |                                       |      |            |
| (6) pump <u>no</u> , <u>no</u><br>(HP) (yield gpm)<br><u>no</u><br>(type power)   |                                       |      |            |
| (7) electric log <u>no</u><br>(yes or no)<br><u>no</u><br>(organization running log)  |                                       |      |            |
| (8) how well bottom plugged <u><i>Rock</i></u>  |                                       |      |            |
| DRILLERS REMARKS:<br><i>Owner will install pump</i>   |                                       |      |            |


APR 21 1969

MISS. BD. OF  
WATER COMM.

⑦

If well telescopes please sketch and show depths.

GROUND LEVEL

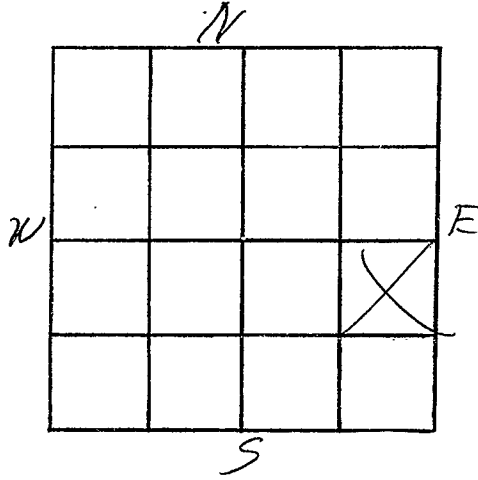

SECTION 4

Please indicate well location X.

ADDITIONAL INFORMATION

If more than one screen, show locations of each on sketch.