

CODED

MISSISSIPPI
BOARD OF WATER COMMISSIONERS
416 North State Street
Jackson, Mississippi 39201

WATER WELL DRILLERS LOG

Lish
L 24
10-20-69

02020 19 *69* *Hughes well* *Lish*
date well completed firm name county well located

LANDOWNER: *James Hays*

Route 1

Lisomings miss
(mailing address)

description of formations encountered

from to

~~sand~~ *Clay*

0 *20*

sand

20 *50*

sand deep clay

50 *160*

WELL LOCATION:

sec. *20* T *6* S R *10* E
4 miles *W* of *Dennis*
(distance) (direction) (nearest town)

WELL PURPOSE: *Home*
(home, irrigation, municipal, industrial)

WELL COMPLETION DATA:

(1) diameter (inches) *6 3/4*

(2) total depth (feet) *160*

(3) static water level (feet) *60* below above top of ground.

(4) casing *Galv* *160*
(material) (depth)

(size) if telescope see back.

(5) screen *6 3/4* *150*
(length) (depth to top)

4" *PLASTIC*
(size) (material)

(6) pump *3/4*
(HP) (yield gpm)

220
(type power)

(7) electric log _____
(yes or no)

(organization running log)

(8) how well bottom plugged *Gravel*
packed

DEC - 3 1969


DRILLERS REMARKS:

d installed 3/4 HP pump

MISC. DD. OF
WATER COMMISSIONERS

If well telescopes please sketch and show depths.

GROUND LEVEL

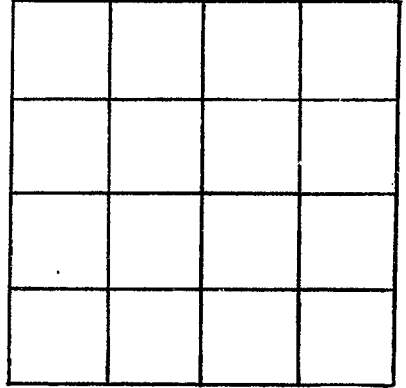

SECTION _____

Please indicate well location X.

ADDITIONAL INFORMATION

If more than one screen, show locations of each on sketch.