

TISHOMINGO
L 35
4-7-73

MISSISSIPPI
 BOARD OF WATER COMMISSIONERS
 416 North State Street
 Jackson, Mississippi 39201

WATER WELL DRILLERS LOG

CODED
 Tishomingo

4-7-1973 Bonds Well Drilling
 date well completed firm name county well located

LANDOWNER: Suther B. Tennison

description of formations encountered from to

Dennis, M.S.
 (mailing address)

Red clay 0 60
water sand 60 120

WELL LOCATION:
 sec. 19 T. 6 N. R. 10 E.
4 miles West of Dennis
 (distance) (direction) (nearest town)

WELL PURPOSE: Home
 (home, irrigation, municipal, industrial)

WELL COMPLETION DATA:

- (1) diameter (inches) 4
- (2) total depth (feet) 120
- (3) static water level (feet) 60 below above top of ground.
- (4) casing Plastic, 120
 (material) (depth)
 _____ if telescope see back.
 (size)
- (5) screen perforate, Casing
 (length) (depth to top)

 (size) (material)
- (6) pump 3/4 5
 (HP) (yield gpm)
Elec.
 (type power)
- (7) electric log no
 (yes or no)


 (organization running log)
- (8) how well bottom plugged plugged

CODED

DRILLERS REMARKS:

If well telescopes please sketch and show depths.

GROUND LEVEL

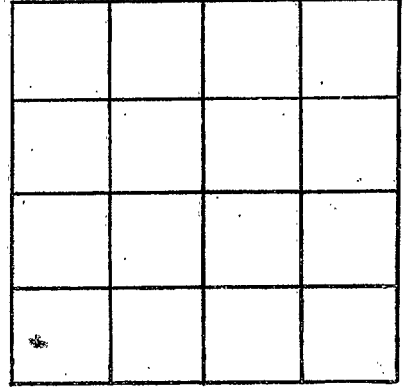

SECTION _____

Please indicate well location X.

ADDITIONAL INFORMATION

If more than one screen,
show locations of each on sketch.