

MISSISSIPPI
BOARD OF WATER COMMISSIONERS
416 North State Street
Jackson, Mississippi 39201

#3

WATER WELL DRILLERS LOG

TISH.
L37
6.7.76
Flg # 73

June 7 1976 J. W. Welles & Sons Jish
date well completed firm name county well located

LANDOWNER:	description of formations encountered	from	to
CITY OF BELMONT	CLAY & SAND	0	25
BELMONT, MISS	SAND & GRAVEL	25	40
(mailing address)	SAND & CLAY	40	60
WELL LOCATION:	CLAY	60	80
sec. 35 T. 65 N. R. 10 E	SAND & GRAVEL	80	120
S W	CLAY	120	150
1 miles N of BELMONT	SAND & GRAVEL	150	180
(distance) (direction) (nearest town)			
WELL PURPOSE: MUNICIPAL			
(home, irrigation, municipal, industrial)			
WELL COMPLETION DATA:			
(1) diameter (inches) 10"			
(2) total depth (feet) 180'			
(3) static water level (feet) 80' below top of ground.			
(4) casing 10' 80' 80'			
(material) (depth) (size) If telescope see back.			
(5) screen 40' 50' near			
(length) (depth to top)			
6 5.5			
(size) (material)			
(6) pump 10 100			
(HP) (yield gpm)			
ELECTRIC			
(type power)			
(7) electric log YES			
(yes or no)			
(organization running log)			
(8) how well bottom plugged BACKWASH VALVE			
DRILLERS REMARKS:			


RECEIVED
JUL 19 1976

MISS. BD. OF WATER COMMS

(X)

If well telescopes please sketch and show depths.

GROUND LEVEL

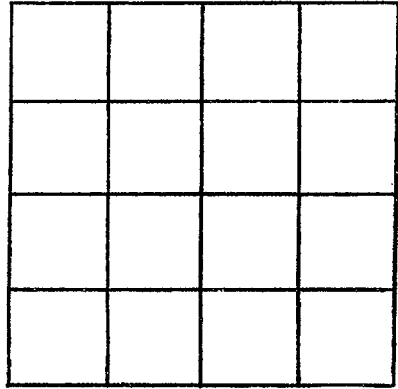

SECTION _____

Please indicate well location X.

ADDITIONAL INFORMATION

A series of horizontal lines for recording additional information, consisting of 20 lines.

If more than one screen, show locations of each on sketch.