

MISSISSIPPI
BOARD OF WATER COMMISSIONERS
416 North State Street
Jackson, Mississippi 39201

CODED

WATER WELL DRILLERS LOG

TISH.
L38
6-76
Flag #74
June 1976

#1

J. W. Webb & Sons

Leik

date well completed

firm name

county well located

LANDOWNER: City of Belmont

description of formations encountered

from to

Belmont miss
(mailing address)

Soil	0	1
Sand Clay & Gravel	1	26
Sand & Clay	26	45
Sand & Clay	45	61
Sand & Gravel	61	80
Sand & Gravel	80	120
Clay	120	158
Sand & Gravel	158	185

WELL LOCATION:

sec. 35 T. 05 N R. 10 E
S W
1 miles N of Belmont
(distance) (direction) (nearest town)

WELL PURPOSE:
(home, irrigation, municipal, industrial)

WELL COMPLETION DATA:

- (1) diameter (inches) 10"
- (2) total depth (feet) 185'
- (3) static water level (feet) 81 below above top of ground.
- (4) casing Steel, 160'
(material) (depth)
0 if telescope see back.
(size)
- (5) screen 30', 120'
(length) (depth to top)
6", stainless steel
(size) (material)
- (6) pump 10 100
(HP) (yield gpm)
Electric
(type power)
- (7) electric log yes
(yes or no)
U.S.N.S.
(organization running log)

(8) how well bottom plugged
Back wash valve

DRILLERS REMARKS:


REGISTERED
JUL 19 1976

MISS. BD. OF WATER COMMISSIONERS



If well telescopes please sketch and show depths.

GROUND LEVEL

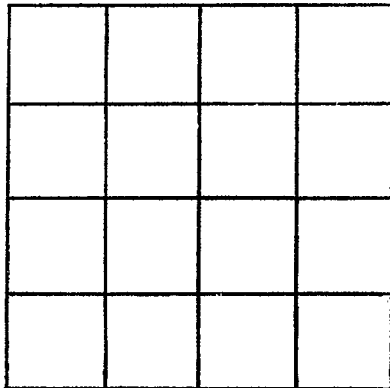

SECTION _____

Please indicate well location X.

ADDITIONAL INFORMATION

If more than one screen, show locations of each on sketch.