

MISSISSIPPI
BOARD OF WATER COMMISSIONERS
416 North State Street
Jackson, Mississippi 39201

CODED

WATER WELL DRILLERS-LOG

#2

TISH
L 39
6-76
No Elog
June 19 76

J. W. Walker Sons, Jackson, Miss
date well completed 19 76 firm name county well located

LANDOWNER: <u>City of Belmont</u>	description of formations encountered	from	to
	Soil	0	1
	Sand & Clay	1	25
(mailing address)	Sandy Clay Gravel	2.5	45
WELL LOCATION:	Sandy Clay	45	60
sec. <u>35</u> T. <u>65</u> N R. <u>10</u> E	Clay	60	80
S S W W	Sandy Gravel	80	120
<u>1</u> miles <u>N</u> of <u>Belmont</u>	Clay	120	160
(distance) (direction) (nearest town)	Sandy Gravel	160	185
WELL PURPOSE: (home, irrigation, municipal, industrial)			
WELL COMPLETION DATA:			
(1) diameter (inches) <u>10"</u>			
(2) total depth (feet) <u>180'</u>			
(3) static water level (feet) <u>79</u> below above top of ground.			
(4) casing <u>Steel</u> , <u>160'</u> (material) (depth)			
(size) if telescope see back.			
(5) screen <u>30'</u> , <u>120'</u> (length) (depth to top)			
<u>6"</u> , <u>5. Steel</u> (size) (material)			
(6) pump <u>10</u> , <u>100</u> (HP) (yield gpm)			
<u>Electric</u> (type power)			
(7) electric log <u>yes</u> (yes or no)			
<u>U.S.H.S.</u> (organization running log)			
(8) how well bottom plugged <u>Backwash valve</u>			
DRILLERS REMARKS:			


RECEIVED
JUL 29 1976

MISS. BD. OF WATER COMMISSIONERS

①

If well telescopes please sketch and show depths.

GROUND LEVEL

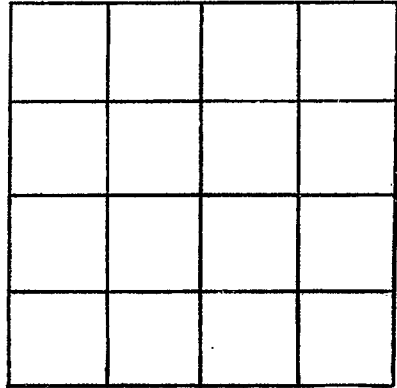

SECTION _____

Please indicate well location X.

ADDITIONAL INFORMATION

A series of 18 horizontal lines provided for entering additional information.

If more than one screen, show locations of each on sketch.