

MISSISSIPPI  
BOARD OF WATER COMMISSIONERS  
416 North State Street  
Jackson, Mississippi 39201

WATER WELL DRILLERS LOG

CODED

TISH.  
L40  
6-76  
Flog 118

#4

June 1976 date well completed

J. W. Webberson firm name

Jackson county well located

LANDOWNER:

CITY OF BELMONT

(mailing address)

WELL LOCATION:

sec. 35 T 65 N R 10 E  
S W  
1 miles N of BELMONT  
(distance) (direction) (nearest town)

WELL PURPOSE:

(home, irrigation, municipal, industrial)

WELL COMPLETION DATA:

- (1) diameter (inches) 10"
- (2) total depth (feet) 185'
- (3) static water level (feet) 80 below top of ground.
- (4) casing STEEL 160'  
(material) (depth)
- (size) if telescope see back.
- (5) screen 30' 120'  
(length) (depth to top)
- 6" S.S.  
(size) (material)
- (6) pump 10 100  
(HP) (yield gpm)
- ELECTRIC  
(type power)
- (7) electric log YES  
(yes or no)
- U. S. G. S.  
(organization running log)
- (8) how well bottom plugged:  
BACKWASH VALVE

description of formations encountered

from to

CLAY & SAND	0	25
SAND & CLAY GRAVEL	25	45
SAND & CLAY	45	60
CLAY	60	80
SAND & GRAVEL	80	120
CLAY	120	160
SAND & GRAVEL	160	185

DRILLERS REMARKS:


RECEIVED  
JUL 19 1976

MISS. BD. OF WATER COMMISSIONERS



If well telescopes please sketch and show depths.

GROUND LEVEL

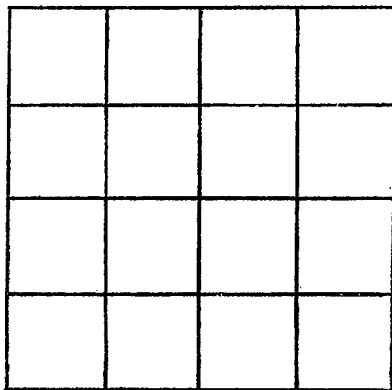

SECTION \_\_\_\_\_

Please indicate well location X.

ADDITIONAL INFORMATION

If more than one screen,  
show locations of each on sketch.