

**MISSISSIPPI  
BOARD OF WATER COMMISSIONERS**  
416 North State Street  
Jackson, Mississippi 39201

**CODED**

**WATER WELL DRILLERS LOG**

**TISHOMINGO**  
**L 46**  
**8/90**  
**Elog #135**

August 1980 Herndon Well & Supply Tishomingo  
date well completed firm name county well located

**LANDOWNER:** Dennis Water Ass'n  
Dennis, MS 38838  
**Well No. 5**  
(mailing address)

**WELL LOCATION:**  
sec 15 T 6 N / S R 10 E / W  
Inside City miles \_\_\_\_\_ of Dennis  
(distance) (direction) (nearest town)

description of formations encountered	from	to
Coarse red sand	0	15
White Chalk	15	22
Red Sand	22	45
Red, White & Gray Chalk	45	63
Gravel	63	160
Blue Clay	160	180

**WELL PURPOSE:**  
(home, irrigation, municipal, industrial)

**CODED**

**WELL COMPLETION DATA:**

(1) diameter (inches) 10

(2) total depth (feet) 145

(3) static water level (feet) 65 below ~~above~~ top of ground.

(4) casing Steel 85  
(material) (depth)

10 x 6 if telescope see back.  
(size)

(5) screen 62 83  
(length) (depth to top)

6" Stainless  
(size) (material)

(6) pump 7½ 95  
(HP) (yield gpm)

Electric  
(type power)

(7) electric log Yes  
(yes or no)

MGS  
(organization running log)

DEPT. OF NATURAL RESOURCES  
BUREAU OF LAND & WATER RESOURCES

(8) how well bottom plugged B.W. Valve

**SEP 25 1980**

**DRILLERS REMARKS:**

**RECEIVED**

7

If well telescopes please sketch and show depths.

GROUND LEVEL


Static W.L.  
65'

Top of Lap  
59'

Top of Screen  
83'

6-20 gravel

Bottom of Well  
145'

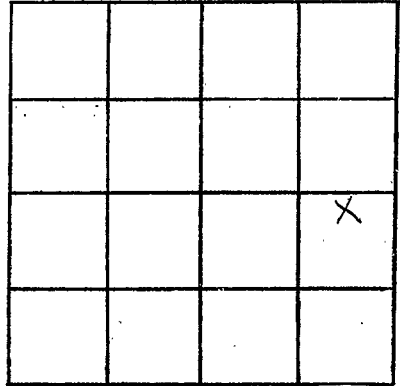

SECTION 15

Please indicate well location X.

ADDITIONAL INFORMATION

Multiple horizontal lines for additional information.

If more than one screen, show locations of each on sketch.