

49 Elog # 146
 TISHOMINGO
 12-00-83

MISSISSIPPI
 BOARD OF WATER COMMISSIONERS
 416 North State Street
 Jackson, Mississippi 39201

CODED

WATER WELL DRILLERS LOG

December 19 83 J. W. Webb & Sons, Inc. Tishomingo
 date well completed firm name county well located

LANDOWNER:	description of formations encountered	from	to
Dennis Water Association			
Dennis, MS	Red Sand, Clay, Small		
(mailing address)	Gravel	18	48
WELL LOCATION:	Sandy shale	80	110
sec. 15 T 6 N R 10 E W	Large Gravel, Fine Sand	110	150
3 miles NW Belmont	Grey Soapstone	48	80
(distance) (direction) of (nearest town)			
WELL PURPOSE: municipal			
(home, irrigation, municipal, industrial)			
WELL COMPLETION DATA:			
(1) diameter (inches) 12"			
(2) total depth (feet) 150			
(3) static water level (feet) 68 below top of ground.			
(4) casing steel, 76' (material), (depth)			
(size) If telescope see back.			
(5) screen 25' 125' (length), (depth to top)			
8" S.S. (size), (material)			
(6) pump 7 1/2 100 (HP), (yield gpm)			
elec. (type power)			
(7) electric log yes (yes or no)			
MSGSS (organization running log)			
(8) how well bottom plugged back wash valve			
DRILLERS REMARKS:			

CODED

DEPT. OF NATURAL RESOURCES
 BUREAU OF LAND & WATER RESOURCES


JUN 20 1984

RECEIVED

7

If well telescopes please sketch and show depths.

GROUND LEVEL

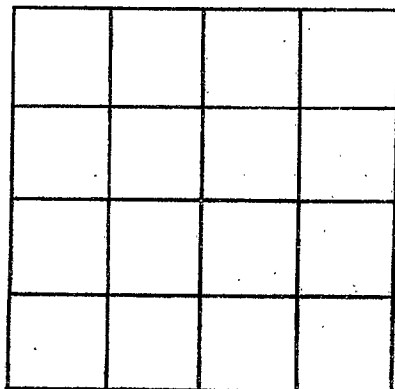

SECTION _____

Please indicate well location X.

ADDITIONAL INFORMATION

Lined area for recording additional information, consisting of approximately 20 horizontal lines.

If more than one screen, show locations of each on sketch.