

MISSISSIPPI DEPARTMENT OF NATURAL RESOURCES

Bureau of Land and Water Resources

Southport Mall

P.O. Box 10631

Jackson, Mississippi 39209

WATER WELL DRILLERS LOG

TISHOMINGO
L 64


MSGW
15283

07/29 19 99 Layne Central Tischimigo
date well completed firm name county well located

LANDOWNER: Dennis Water Assoc	description of formations encountered	from	to
Junction of RR Tracks			
Hwy 25 (mailing address)			
WELL LOCATION: sec. 15 T 6 N S R 10 E W 1 miles North of Dennis (distance) (direction) (nearest town)			
WELL PURPOSE: Municipal (home, irrigation, municipal, industrial)			
WELL COMPLETION DATA:			
(1) diameter (inches) 10"			
(2) total depth (feet) 155"			
(3) static water level (feet) 72 below above top of ground.			
(4) casing Steel 138' (material) (depth) 10" if telescope see back. (size)			
(5) screen 15' 138' (length) (depth to top) 6" 304 SST (size) (material)			
(6) pump 10 (HP) (yield gpm) 230V (type power)			
(7) electric log yes (yes or no) Layne (organization running log)			
(8) how well bottom plugged cement			
DRILLERS REMARKS: Well #8			

If well telescopes please sketch and show depths.

GROUND LEVEL

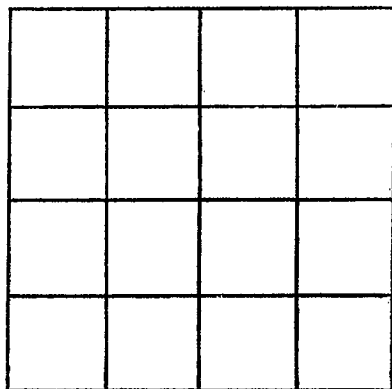

SECTION _____

Please indicate well location X.

ADDITIONAL INFORMATION

If more than one screen,
show locations of each on sketch.