

TUNICA MISSISSIPPI BOARD OF WATER COMMISSIONERS

A 9
7-3-62

WATER WELL DRILLERS LOG

CODED

Date: July 3, 1962, Driller: Layne-Central Company, County Tunica
(Name)

(1) Owner of Land: C. P. Owen
(Name)
Robinsonville, Mississippi
(Address)

(2) Location: 1/4, 1/4, Sec. 26 T3 R11
miles of Bowdre
(distance) (direction) (Nearest Town)

(3) Topography: flat
(Hilly) (Flat) (Level)


(4) Purpose of Well: domestic
(Domestic Irrigation
Municipal, Industrial, Other)

Information upon completion of well:

- (1) Diameter 4x3 inches.
(2) Total Depth 1654'5" feet.
(3) Water Level 4 feet below top of ground.
(4) Cased to 125', Size 4"
1485'10" 3"
(5) Screen: Size 3", Length 40'7"
3' tail pipe and washout valve
(6) Were any formations sealed against pollution?
yes yes, no no.

If YES depth of formation 2 shirt tail
packers. One packer 20' above
screen. One packer when hole
Why is reduced from 7-7/8 to 5-5/8.

Drillers Remarks:

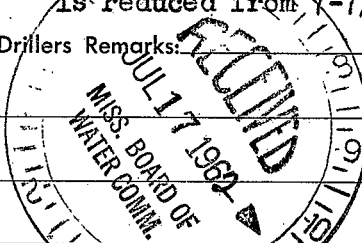

Description & Color of Materials Sand, Clay, Red Clay, Shell, etc.	Thick- ness Feet	Depth Feet
Clay	22	22
Fine blue sand	23	45
Coarse sand	51	96
Coarse sand & pea gravel	19	115
Coarse sand	20	135
Coarse sand & pea gravel	9	144
Clay	49	193
Sandy clay	24	217
Clay	11	228
Sandy clay	46	274
Clay	43	317
Sand, strks. shale	45	362
Shale	44	406
Sandy shale	64	470
Rock	2	472
Sandy shale	28	500
White sandy clay	32	532
Sand	45	577
Sand, strks. clay	11	588
Sand	18	606
Shale	30	636
Sand	103	739
Sand, strks. shale	28	767
Sand	101	868
Sand, strks, shale	28	896
Shale	22	918
Sand	65	983
Sand, strks. shale	25	1008
Sand	190	1198
Sandy shale	20	1218
Shale, strks. rocks	18	1236
Hard shale	38	1274

(Over)

(Use Back Side)

Well No.

Sandy shale	16	1290
Shale	73	1363
Sandy shale	91	1454
Shale	19	1473
Sandy shale	25	1498
Hard shale	5	
Sandy shale	15	1518
Shale	33	1551
Sandy shale	8	1559
Sand	95	1654